

PEARL RIVER

0 2018

11-24-78

MISSISSIPPI BOARD OF WATER COMMISSIONERS
416 North State Street
Jackson, Mississippi 39201

WATER WELL DRILLERS LOG

11-24-1978 Red Mountain Water Wells, Inc Pearl River
date well completed firm name county well located

LANDOWNER: Nancy & Mike Hunter

description of formations encountered

from to

Rt. 1 Box 256
Carriere, Ms 39426
(mailing address)

Top. clay
Sand
Water bearing sand

200'
0 8'
8 20'
20 210'

WELL LOCATION:

sec. 24 T. 4 N R. 18 E
1/4 miles (distance) S of Carriere (nearest town)

WELL PURPOSE: HOME -
(home, irrigation, municipal, industrial)

WELL COMPLETION DATA:

- (1) diameter (inches) 4"
- (2) total depth (feet) 40'
- (3) static water level (feet) 17' below top of ground.
- (4) casing PVC, 40' (material), (depth)
(size) if telescope see back.
- (5) screen 10' 30' (length), (depth to top)
10' x 4" PVC (size), (material)
- (6) pump 1/2 (HP), 8 (yield gpm)
220 Volt AC (type power)
- (7) electric log (yes or no)
(organization running log)

(8) how well bottom plugged
2" sand & wash valve


DRILLERS REMARKS:

RECEIVED
JAN 23 1978

MISS. BD. OF WATER COMMISSIONERS

If well telescopes please sketch and show depths.

GROUND LEVEL

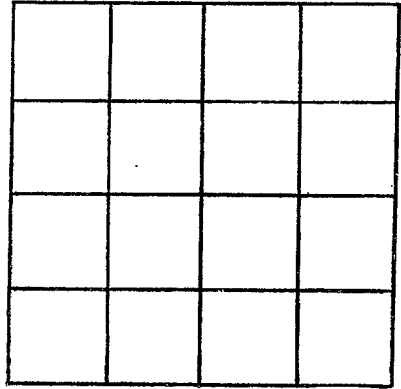

SECTION _____

Please indicate well location X.

ADDITIONAL INFORMATION

A series of horizontal lines for entering additional information, starting below the 'ADDITIONAL INFORMATION' header and extending to the bottom of the page.

If more than one screen, show locations of each on sketch.