

Pearl River
 Q 2020
 3/7/79

MISSISSIPPI
 BOARD OF WATER COMMISSIONERS
 416 North State Street
 Jackson, Mississippi 39201

WATER WELL DRILLERS LOG

3/7 1979 *And Penton* Pearl River
 date well completed firm name county well located

LANDOWNER: *M. Case*
Rt. 1 carriers 73 55
 (mailing address)

description of formations encountered	from	to
<i>Red shale</i>	<i>0</i>	<i>109</i>
<i>Blue shale</i>	<i>109</i>	<i>265</i>
<i>Gray sand</i>	<i>265</i>	<i>305</i>

WELL LOCATION:
 sec. 18 T. 4 N R. 18 E
 S W
 (distance) miles (direction) of (nearest town)

WELL PURPOSE:
 (home, irrigation, municipal, industrial)

- WELL COMPLETION DATA:
- (1) diameter (inches) 2"
 - (2) total depth (feet) 305
 - (3) static water level (feet) 125 below above top of ground.
 - (4) casing PVC, 305
 (material) (depth)
 (size) if telescope see back.
 - (5) screen 2x10, 295
 (length) (depth to top)
12, PVC
 (size) (material)
 - (6) pump 1/2, 350
 (HP) (yield gpm)
Elect
 (type power)
 - (7) electric log NO
 (yes or no)

(organization running log)
 (8) how well bottom plugged *plugged*

DRILLERS REMARKS:


Miss. Board of Water Comm.

JUL 30 1979

RECEIVED

If well telescopes please sketch and show depths.

GROUND LEVEL

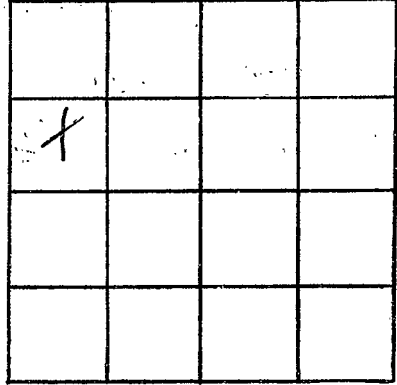

SECTION _____

Please indicate well location X.

ADDITIONAL INFORMATION

If more than one screen, show locations of each on sketch.