

14

MISSISSIPPI
 BOARD OF WATER COMMISSIONERS
 416 North State Street
 Jackson, Mississippi 39201

Pearl Ri.
Ø 2023
8-20-77

WATER WELL DRILLERS LOG

8/20 19 77 Bud Denton Pearl River
 date well completed firm name county well located

LANDOWNER: nickel
arnsworth
RT-1 Carriere Miss.
 (mailing address)

description of formations encountered		from	to
<u>Red shale</u>		<u>20</u>	<u>20</u>
<u>Red sand</u>		<u>20</u>	<u>97</u>

WELL LOCATION:
 sec. 26 T-4 N R-18 E
8 miles West of Carriere
 (distance) (direction) (nearest town)

WELL PURPOSE: home
 (home, irrigation, municipal, industrial)

WELL COMPLETION DATA:

(1) diameter (inches) 2"
97

(2) total depth (feet) 97

(3) static water level (feet) 42 below
 top of ground. above

(4) casing PVC, 82
 (material) (depth)

770 if telescope see back.
 (size)

(5) screen 10', 82
 (length) (depth to top)

12, PVC
 (size) (material)

(6) pump 1/2, 300 gpm
 (HP) (yield gpm)

Elect
 (type power)

(7) electric log no
 (yes or no)

(organization running log)

(8) how well bottom plugged
Sandstone

DRILLERS REMARKS:


DEPT. OF NATURAL RESOURCES
 BUREAU OF LAND & WATER RESOURCES

JAN 7 1980

RECEIVED

If well telescopes please
sketch and show depths.

GROUND LEVEL

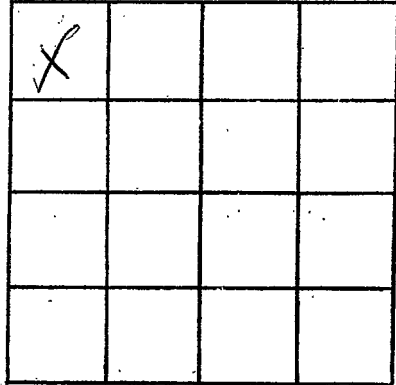

SECTION _____

Please indicate well location X.

ADDITIONAL INFORMATION

If more than one screen,
show locations of each on sketch.