

Pearl Ri.
 2026
 9-19-79

MISSISSIPPI
 BOARD OF WATER COMMISSIONERS
 416 North State Street
 Jackson, Mississippi 39201

WATER WELL DRILLERS LOG

9/19 date well completed 1979 Bud Perton firm name Pearl River county well located

LANDOWNER: Andrew Gutter
 Bt c 1 Carriere Miss (mailing address)

description of formations encountered	from	to
Red shale	0	20
Red sand	20	96
White shale	96	200
Gray sand	200	227

WELL LOCATION:
 sec 26 T 4 N R 18 E
 6 miles W of Carriere
 (distance) (direction) (nearest town)

WELL PURPOSE: home
 (home, irrigation, municipal, industrial)

- WELL COMPLETION DATA:
- (1) diameter (inches) 4"
 - (2) total depth (feet) 227
 - (3) static water level (feet) 121 below top of ground.
 - (4) casing PVC, 217 (material) (depth)
 (size) if telescope see back.
 - (5) screen 10, 217 (length) (depth to top)
 12, PVC (size) (material)
 - (6) pump 1, 650 gpm (HP) (yield gpm)
 Elect. (type power)
 - (7) electric log no (yes or no)

(organization running log)
 (8) how well bottom plugged Sand stop

DRILLERS REMARKS:


DEPT. OF NATURAL RESOURCES
 BUREAU OF LAND & WATER RESOURCES

JAN 7 1980

RECEIVED

If well telescopes please sketch and show depths.

GROUND LEVEL

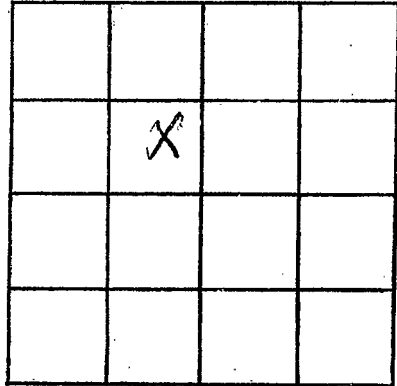

SECTION _____

Please indicate well location X.

ADDITIONAL INFORMATION

Lined area for additional information.

If more than one screen, show locations of each on sketch.