

PEARL RIVER

Φ 2027

5-3-79

MISSISSIPPI BOARD OF WATER COMMISSIONERS
416 North State Street
Jackson, Mississippi 39201

WATER WELL DRILLERS LOG

85-03
date well completed

1979 Folsom Water Well Serv
firm name

PEARL RIVER
county well located

LANDOWNER: Mrs. Deana Byrd

(mailing address)

description of formations encountered	from	to
Clay	0	18'
Red sand	18	35'
White clay		
turning blue	35	155'
Sand and gravel	155	175'

WELL LOCATION:
sec. 11 T-4 R 18 E
7 miles South of Crossroad
(distance) (direction) (nearest town)

WELL PURPOSE: Home
(home, irrigation, municipal, industrial)

WELL COMPLETION DATA:

- (1) diameter (inches) 4
- (2) total depth (feet) 175'
- (3) static water level (feet) 145' below above top of ground.
- (4) casing (material) PVC (depth) 165'
- 4" (size) if telescope see back.
- (5) screen 10' (length) 165' (depth to top)
- 4" x 0.014" (size) PVC (material)
- (6) pump 1 (HP) 15 (yield gpm)
- 230V AC (type power)
- (7) electric log NO (yes or no)

(organization running log)

(8) how well bottom plugged FLOAT
Type B W V

DRILLERS REMARKS:


Miss. Board of Water Comm.

JUN 11 1979

RECEIVED

If well telescopes please sketch and show depths.

GROUND LEVEL

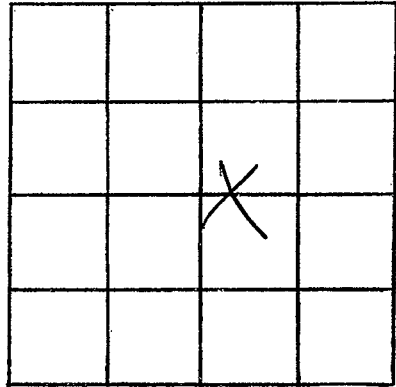

SECTION 11

Please indicate well location X.

ADDITIONAL INFORMATION

If more than one screen, show locations of each on sketch.