

Pearl River
 # 2030
 10-3-80

MISSISSIPPI
 BOARD OF WATER COMMISSIONERS
 416 North State Street
 Jackson, Mississippi 39201

WATER WELL DRILLERS LOG

10/3 1980 date well completed 80 Budington Water Well Service firm name Pearl River county well located

LANDOWNER: Wayne Mitchell RT 1
Carriere Miss
 (mailing address)

description of formations encountered	from	to
Red shale	0	12
Red sand	12	65
Blue shale	65	450
Blue sand	450	495

WELL LOCATION:
 sec. 26 T. 4 N. R. 18 E
7 miles West of Carriere
 (distance) (direction) (nearest town)

WELL PURPOSE: home
 (home, irrigation, municipal, industrial)

- WELL COMPLETION DATA:
- diameter (inches) 4"
 - total depth (feet) 495
 - static water level (feet) 120 below above top of ground.
 - casing PVC, 480
 (material) (depth)
(size) if telescope see back.
 - screen 15, 480
 (length) (depth to top)
12, PVC
 (size) (material)
 - pump 1, 135 DM
 (HP) (yield gpm)
Elect
 (type power)
 - electric log no
 (yes or no)

DEPT. OF NATURAL RESOURCES
 BUREAU OF LAND & WATER RESOURCES

OCT - 8 1980

RECEIVED


(organization running log)

(8) how well bottom plugged Sand

DRILLERS REMARKS: Shark

If well telescopes please sketch and show depths.

GROUND LEVEL

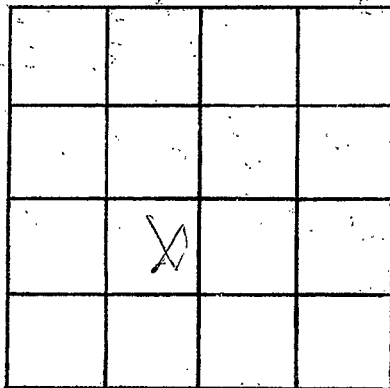

SECTION _____

Please indicate well location X.

ADDITIONAL INFORMATION

If more than one screen, show locations of each on sketch.