

Pearl River
Φ 2031
4/23/80

MISSISSIPPI
 BOARD OF WATER COMMISSIONERS
 416 North State Street
 Jackson, Mississippi 39201

WATER WELL DRILLERS LOG

4/23 1980 Bud Benton Waterwell Pearl River
 date well completed firm name county well located

LANDOWNER: Leola Day Murray
R.T. 1 Carriere
 (mailing address)

description of formations encountered	from	to
<u>Red shale</u>	<u>0</u>	<u>35</u>
<u>Red sand</u>	<u>35</u>	<u>50</u>
<u>Blue shale</u>	<u>50</u>	<u>110</u>
<u>gray sand</u>	<u>110</u>	<u>480</u>

WELL LOCATION:
 sec. 26 T 4 N R 13 E
 S W
~~1/2~~ 1/2 miles west of well
 (distance) (direction) (nearest town)

WELL PURPOSE: home
 (home, irrigation, municipal, industrial)

- WELL COMPLETION DATA:
- (1) diameter (inches) 4"
 - (2) total depth (feet) 480
 - (3) static water level (feet) 27 below top of ground.
 - (4) casing PVC, 470,
 (material) (depth)
 - (size) if telescope see back.
 - (5) screen 10, 470
 (length) (depth to top)
 - 1/2, PVC
 (size) (material)
 - (6) pump 1, 1315
 (HP) (yield gpm) 1m
 - Elec.
 (type power)
 - (7) electric log no
 (yes or no)


(organization running log)
 (8) how well bottom plugged off sand

DRILLERS REMARKS:

DEPT. OF NATURAL RESOURCES
 BUREAU OF LAND & WATER RESOURCES
 OCT - 8 1980
 RECEIVED

If well telescopes please sketch and show depths.

GROUND LEVEL

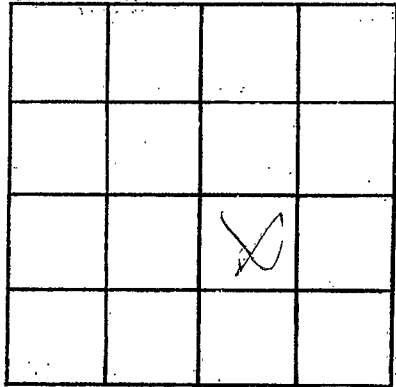

SECTION _____

Please indicate well location X.

ADDITIONAL INFORMATION

A series of horizontal lines for writing additional information.

If more than one screen, show locations of each on sketch.