

Pearl River
 2032
 5/23/80

MISSISSIPPI
 BOARD OF WATER COMMISSIONERS
 416 North State Street
 Jackson, Mississippi 39201

WATER WELL DRILLERS LOG

4/10 1980 Bedford Water Pearl River
 date well completed firm name county well located
Well Service

LANDOWNER: Neal Haspen
R.T. 1 Box 275 Corriere
Miss.
 (mailing address)

description of formations encountered	from	to
<u>Red shale</u>	<u>0</u>	<u>21</u>
<u>Red sand</u>	<u>21</u>	<u>36</u>

WELL LOCATION:
 sec. 26 T-4 N R-18 E
6 miles West of Corriere
 (distance) (direction) (nearest town)

WELL PURPOSE: None
 (home, irrigation, municipal, industrial)

- WELL COMPLETION DATA:
- (1) diameter (inches) 4"
 - (2) total depth (feet) 36
 - (3) static water level (feet) 42 below above top of ground.
 - (4) casing PVC, 36
 (material) (depth)
 (size) if telescope see back.
 - (5) screen 10, 76
 (length) (depth to top)
12, PVC
 (size) (material)
 - (6) pump no
 (HP) (yield gpm)
 (type power)
 - (7) electric log no
 (yes or no)

(organization running log)
 (8) how well bottom plugged shale

DRILLERS REMARKS:
no pump
furnish


DEPT. OF NATURAL RESOURCES
 BUREAU OF LAND & WATER RESOURCES

MAY 19 1980

RECEIVED

If well telescopes please sketch and show depths.

GROUND LEVEL

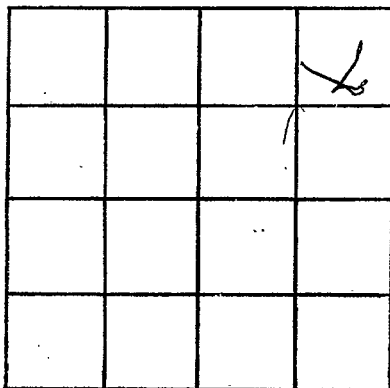

SECTION _____

Please indicate well location X.

ADDITIONAL INFORMATION

Lined area for additional information.

If more than one screen, show locations of each on sketch.