

PEARL RIVER

MISSISSIPPI  
BOARD OF WATER COMMISSIONERS  
416 North State Street  
Jackson, Mississippi 39201

2033

WATER WELL DRILLERS LOG

5/30/80  
5/30/80

1980 Red Martin Water Well P. Riv

date well completed

firm name

county well located

LANDOWNER:

Willie J Smith  
Rt. 1, Box 183  
Carrington, Miss 39420  
(mailing address)

description of formations encountered

from

to

top soil		
clay	1	50
silica sand	50	70
clay	70	200
fine water sand	200	240
clay	240	265
fine sand	265	285
clay	285	315
Water sand		

WELL LOCATION:

sec 3 T 4 R 18 W  
10 miles North W of Gaynes  
(distance) (direction) (nearest town)

WELL PURPOSE: Home  
(home, irrigation, municipal, industrial)

WELL COMPLETION DATA:

- (1) diameter (inches) 4"
- (2) total depth (feet) 315'
- (3) static water level (feet) 150' below top of ground
- (4) casing P.V.C. 315' (material) (depth)  
4" (size) if telescope see back.
- (5) screen 10' 305' (length) (depth to top)  
4" (size) P.V.C. (material)
- (6) pump 1 (HP) 14 Gpm (yield gpm)  
230-volt (type power)
- (7) electric log (yes or no)
- (8) how well bottom plugged sand shale value

DEPT. OF NATURAL RESOURCES  
BUREAU OF LAND & WATER RESOURCES


JUN 10 1980

DRILLERS REMARKS:

RECEIVED

If well telescopes please sketch and show depths.

GROUND LEVEL

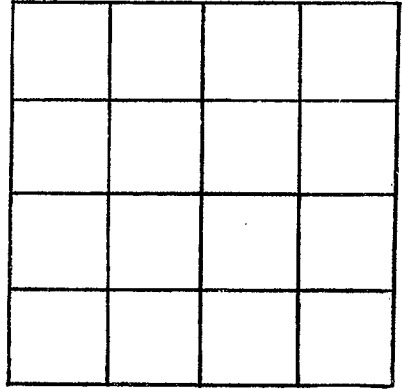

SECTION \_\_\_\_\_

Please indicate well location X.

ADDITIONAL INFORMATION

If more than one screen, show locations of each on sketch.