

PEARL RIVER

MISSISSIPPI
BOARD OF WATER COMMISSIONERS
416 North State Street
Jackson, Mississippi 39201

WATER WELL DRILLERS LOG

Handwritten initials and numbers
2034

6/2/80 1980 Red Martin Water Well Pk River
date well completed firm name county well located

LANDOWNER: Richard H. Smith
Carriene Miss 39436
Rt 1 Box 187
(mailing address)

WELL LOCATION:
sec. 3 T 4 N R 18W
S W
10 miles N of Picayune
(distance) (direction) (nearest town)

WELL PURPOSE: Home
(home, irrigation, municipal, industrial)

- WELL COMPLETION DATA:
- (1) diameter (inches) 4"
 - (2) total depth (feet) 310'
 - (3) static water level (feet) 165 below above top of ground.
 - (4) casing PVC, 4"
(material) (depth)
4"
(size) If telescope see back.
 - (5) screen 10' 300'
(length) (depth to top)
4" PVC
(size) (material)
 - (6) pump 1" 14 Ser.
(HP) (yield gpm)
230 Volt
(type power)
 - (7) electric log X
(yes or no)
(organization running log)
 - (8) how well bottom plugged Sank
Shark Valve

description of formations encountered	from	to
<u>top soil</u>		
<u>clay</u>	<u>0</u>	<u>20</u>
<u>dry sand</u>	<u>20</u>	<u>40</u>
<u>clay</u>	<u>40</u>	<u>70</u>
<u>fine sand</u>		
<u>mud</u>	<u>190</u>	<u>220</u>
<u>clay</u>	<u>220</u>	<u>258</u>
<u>limb sand</u>		
<u>mud</u>	<u>260</u>	<u>280</u>
<u>coarse water</u>		
<u>sand</u>	<u>280</u>	<u>310</u>

DEPT. OF NATURAL RESOURCES
BUREAU OF LAND & WATER RESOURCES


JUN 10 1980

RECEIVED

DRILLERS REMARKS:

If well telescopes please sketch and show depths.

GROUND LEVEL

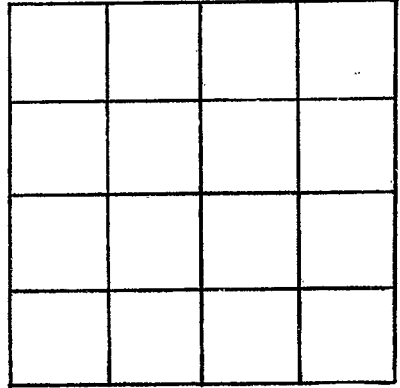

SECTION _____

Please indicate well location X.

ADDITIONAL INFORMATION

If more than one screen, show locations of each on sketch.