

BOARD OF WATER COMMISSIONERS

416 North State Street

Jackson, Mississippi 39201

WATER WELL DRILLERS LOG

River
Ø 2035
5-29-80

5/29 1980 date well completed
Pearl River firm name
Pearl River county well located

LANDOWNER: Berry Conkle
R.T. 1 Carriere Miss
(mailing address)

Description of formations encountered	from	to
<u>Red Shale</u>	<u>0</u>	<u>38</u>
<u>Red Sand</u>	<u>38</u>	<u>110</u>
<u>Blue Shale</u>	<u>110</u>	<u>498</u>
<u>Blue Sand</u>	<u>498</u>	<u>5740</u>

WELL LOCATION:
sec. 06 T 4 N R. 18 E
S W
6 1/2 miles west of Mermentau
(distance) (direction) (nearest town)

WELL PURPOSE: water
(home, irrigation, municipal, industrial)

- WELL COMPLETION DATA:
- (1) diameter (inches) 4"
 - (2) total depth (feet) 5740
 - (3) static water level (feet) 8 1/2 below top of ground.
 - (4) casing PVC, 530,
(material) (depth)
(size) if telescope see back.
 - (5) screen 12, 530
(length) (depth to top)
(size) (material)
 - (6) pump 1 1/2, 1660
(HP) (yield gpm hr)
(type power)
 - (7) electric log no
(yes or no)
 - (organization running log)
 - (8) how well bottom plugged Shor's

DEPT. OF NATURAL RESOURCES
BUREAU OF LAND & WATER RESOURCES


OCT - 9 1980

RECEIVED

DRILLERS REMARKS:

If well telescopes please sketch and show depths.

GROUND LEVEL

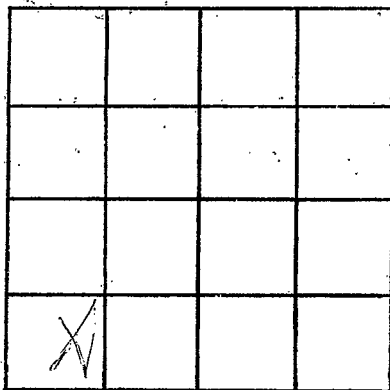

SECTION _____

Please indicate well location X.

ADDITIONAL INFORMATION

If more than one screen,
show locations of each on sketch.