

MISSISSIPPI DEPARTMENT OF NATURAL RESOURCES

Bureau of Land and Water Resources

Southport Mall

P.O. Box 10631

Jackson, Mississippi 39209

WATER WELL DRILLERS LOG

BOUNCY WATER WELL DRILLING

PEARL RIVER

Pearl River  
 # 2030  
 7-23-81

7-23-81  
 date well completed

BOUNCY WATER WELL DRILLING  
 firm name

PEARL RIVER  
 county well located

LANDOWNER: George Burks  
 Shenfield

description of formations encountered

from

to

Top. @ 9  
 Silt and Junk. 9 72  
 Fair Silt Junky - 72 80

(mailing address)

WELL LOCATION:

sec 35 T 4 N R 18 E  
 6 miles N/W of Picayune  
 (distance) (direction) (nearest town)

WELL PURPOSE: Home  
 (home, irrigation, municipal, industrial)

WELL COMPLETION DATA:

- (1) diameter (inches) 2
- (2) total depth (feet) 80
- (3) static water level (feet) 45 below top of ground
- (4) casing PVC 70 (material), (depth), 2 (size) if telescope see back.
- (5) screen 10, 70 (length), (depth to top), 2 PVC (size), (material)
- (6) pump 1 (HP), (yield & gpm) AC 220 (type power)
- (7) electric log (yes or no)
- (8) how well bottom plugged Sealed

DEPT. OF NATURAL RESOURCES  
 BUREAU OF LAND & WATER RESOURCES

SEP 18 1981


RECEIVED

RECEIVED  
 SEP 1981  
 1 2 3 4 5 6 7 8 9 10 11 12 13 14 15 16 17 18 19 20 21 22 23 24 25 26 27 28 29 30 31

DRILLERS REMARKS: It was large enough but didn't look clean well cleaned

If well telescopes please sketch and show depths.

GROUND LEVEL

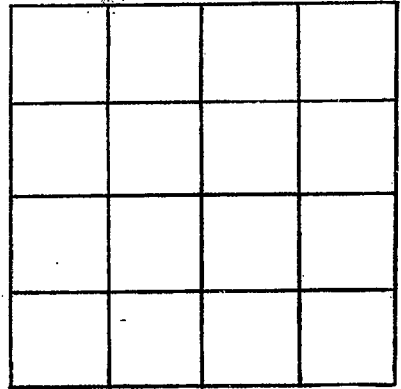

SECTION \_\_\_\_\_

Please indicate well location X.

ADDITIONAL INFORMATION

If more than one screen,  
show locations of each on sketch.