

MISSISSIPPI DEPARTMENT OF NATURAL RESOURCES

Bureau of Land and Water Resources

Southport Mall

P.O. Box 10631

Jackson, Mississippi 39209

WATER WELL DRILLERS LOG

BUD PENTON & SON
WATER WELL SERVICE
ROUTE 3 BOX 41

P. River

firm name CARRIERE, MS 39426 county well located
PHONE 798-5324

Pearl River
Q 2037
6/29/81

6/29 1981
date well completed

LANDOWNER: John McLaughlin

description of formations encountered

from to

BT-1 McNeil
Miss: 80 acres
(mailing address)

Red shale	0	50
Red sand	60	72
Blue shale	72	705
Gray sand	705	260

WELL LOCATION:

sec. 25 T. 24 N. R. 18 E.
S W
6 miles West of McNeil
(distance) (direction) (nearest town)

WELL PURPOSE: home
(home, irrigation, municipal, industrial)

WELL COMPLETION DATA:

- (1) diameter (inches) 4"
- (2) total depth (feet) 260
- (3) static water level (feet) 110 below above top of ground.
- (4) casing pvc, 260
(material) (depth)

(size) if telescope see back.

- (5) screen 10, 260
(length) (depth to top)

10, pvc
(size) (material)

- (6) pump 3/4, 450
(HP) (yield gpm)


Elect
(type power)

- (7) electric log no
(yes or no)

(organization running log)

- (8) how well bottom plugged sand shale

DRILLERS REMARKS:

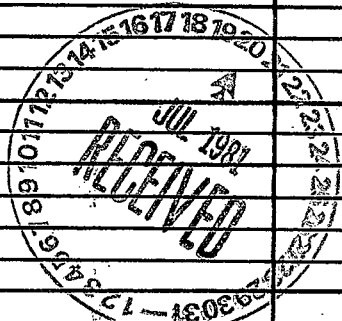

If well telescopes please sketch and show depths.

GROUND LEVEL

X			

SECTION _____

Please indicate well location X.

ADDITIONAL INFORMATION

If more than one screen,
show locations of each on sketch.