

MISSISSIPPI DEPARTMENT OF NATURAL RESOURCES

Bureau of Land and Water Resources

Southport Mall

P.O. Box 10631

Jackson, Mississippi 39209

SWP PESTONEL DRILLERS LOG

WATER WELL SERVICE

ROUTE 3 BOX 41

CARRIERS, MS 39426

PHONE 768-5324

Pearl River
 2038
 7-9-81

7-9-81
 date well completed

Paul R...
 county well located

LANDOWNER: <i>Henry field, Mrs.</i>	description of formations encountered	from	to
(mailing address)	<i>Red shale</i>	0	25
WELL LOCATION:	<i>Red sand</i>	25	58'
sec. <i>26</i> T <i>4</i> N R <i>18</i> E <i>3</i> miles <i>N</i> of <i>Cypress</i> (distance) (direction) (nearest town)			
WELL PURPOSE: <i>Home</i> (home, irrigation, municipal, industrial)			
WELL COMPLETION DATA:			
(1) diameter (inches) <i>4"</i>			
(2) total depth (feet) <i>58'</i>			
(3) static water level (feet) <i>30</i> below above top of ground.			
(4) casing <i>PVC</i> <i>48</i> (material) (depth)			
_____ if telescope see back. (size)			
(5) screen <i>10'</i> <i>48'</i> (length) (depth to top)			
_____ <i>4"</i> _____ <i>PVC</i> (size) (material)			
(6) pump <i>1/2</i> <i>1200</i> (HP) (yield gpm)			
_____ <i>she</i> (type power)			
(7) electric log _____ (yes or no)			
_____ (organization running log)			
(8) how well bottom plugged <i>Sand</i> <i>Shale</i>			
DRILLERS REMARKS: _____			


DEPT. OF NATURAL RESOURCES
 BUREAU OF LAND & WATER RESOURCES

NOV 9 - 1981

RECEIVED

If well telescopes please sketch and show depths.

GROUND LEVEL

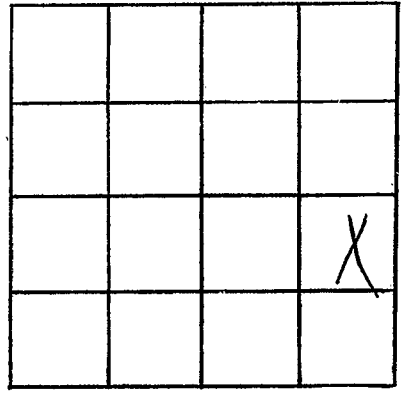

SECTION _____

Please indicate well location X.

ADDITIONAL INFORMATION

A series of horizontal lines for writing additional information.

If more than one screen, show locations of each on sketch.