

MISSISSIPPI DEPARTMENT OF NATURAL RESOURCES

Bureau of Land and Water Resources

Southport Mall

P.O. Box 10631

Jackson, Mississippi 39209

WATER WELL DRILLERS LOG

BUD PENTON & SON
WATER WELL SERVICE
ROUTE 3, BOX 41

CARROLLTON, MS 39426
PHONE 798-5324

Pearl River

Pearl River
Ø 2040
8-7-81

8-7-1981
date well completed

county well located

LANDOWNER: Miller, Harold

Hardyfield Ms

(mailing address)

description of formations encountered

from

to

Red shale

0

25

Red sand

25

75

WELL LOCATION:

sec 23 T 4 N R 18 E
1 miles W of Hardyfield
(distance) (direction) (nearest town)

WELL PURPOSE: Home
(home, irrigation, municipal, industrial)

WELL COMPLETION DATA:

- (1) diameter (inches) 2
- (2) total depth (feet) 751
- (3) static water level (feet) 40 below above top of ground.
- (4) casing PVC 65 (material) (depth)
- (size) if telescope see back.
- (5) screen 10 65 (length) (depth to top)
- 2 PVC (size) (material)
- (6) pump 1 800 (HP) (yield gpm)
- elec (type power)
- (7) electric log (yes or no)

(organization running log)

(8) how well bottom plugged
Sand
Mud

DRILLERS REMARKS:

DEPT. OF NATURAL RESOURCES
BUREAU OF LAND & WATER RESOURCES

NOV 9 - 1981


RECEIVED

If well telescopes please sketch and show depths.

GROUND LEVEL

20 0
25 25

Red pipe
Red pipe

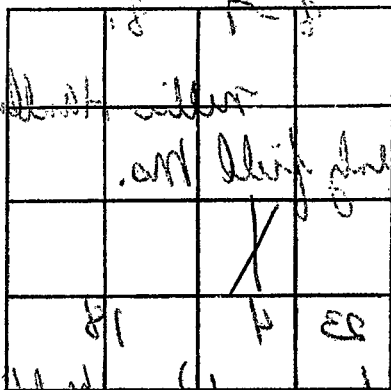

SECTION

Please indicate well location X.

ADDITIONAL INFORMATION

10
25
10
20 100
20 10
20 10
20 1
20

If more than one screen, show locations of each on sketch.