

MISSISSIPPI DEPARTMENT OF NATURAL RESOURCES

Bureau of Land and Water Resources

Southport Mall

P.O. Box 10631

Jackson, Mississippi 39209

WATER WELL DRILLERS LOG

BUD PENTON & SON
WATER WELL SERVICE
ROUTE 3, BOX 41
CANTON, MISSISSIPPI 39426
PHONE 768-5324

county well located

date well completed

LANDOWNER: *Mrs. Moyra*

description of formations encountered

from to

Hwyfield Mrs
(mailing address)

description of formations encountered	from	to
<i>Grey shale</i>	<i>0</i>	<i>40</i>
<i>White sand</i>	<i>40</i>	<i>60</i>
<i>Grey sand</i>	<i>60</i>	<i>90</i>
<i>Blue shale</i>	<i>90</i>	<i>180</i>
<i>Grey sand</i>	<i>180</i>	<i>220</i>

WELL LOCATION:

sec. *8* T. *4* N. R. *17* E.
3 miles *NW* of *Hwyfield*
(distance) (direction) (nearest town)

WELL PURPOSE: *Home*
(home, irrigation, municipal, industrial)

WELL COMPLETION DATA:

- (1) diameter (inches) *4*
- (2) total depth (feet) *220*
- (3) static water level (feet) *165* below above top of ground.
- (4) casing *PVC* *210*
(material) (depth)
4 if telescope see back.
(size)
- (5) screen *10* *210*
(length) (depth to top)
4 *PVC*
(size) (material)
- (6) pump *1* *1300*
(HP) (yield gpm)
elec.
(type power)
- (7) electric log _____
(yes or no)

(organization running log)

(8) how well bottom plugged *full*

DRILLERS REMARKS: _____


DEPT. OF NATURAL RESOURCES
BUREAU OF LAND & WATER RESOURCES

NOV 9 1981

RECEIVED

If well telescopes please sketch and show depths.

GROUND LEVEL

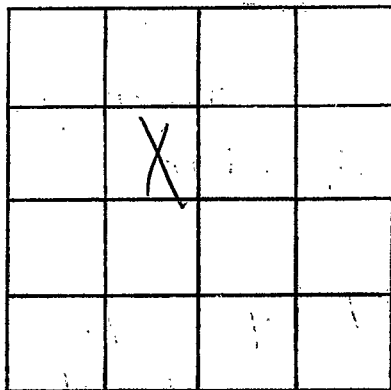

SECTION _____

Please indicate well location X.

ADDITIONAL INFORMATION

If more than one screen,
show locations of each on sketch.