

MISSISSIPPI DEPARTMENT OF NATURAL RESOURCES

Bureau of Land and Water Resources

Southport Mall

P.O. Box 10631

Jackson, Mississippi 39209

WATER WELL DRILLERS LOG

Pearl River  
~~0 2012~~  
 8/21/81

8-21-81  
 date well completed

BUD PENTON & SON  
 WATER WELL SERVICE  
 ROUTE BOX 41  
 CARRIERE, MS 39426

Pearl River  
 county well located

LANDOWNER: Tommy Jones  
Henlyfield, Ms.

description of formations encountered	from	to
<u>Red shale</u>	<u>0</u>	<u>15</u>
<u>Red sand</u>	<u>15</u>	<u>70</u>
<u>gray sand</u>	<u>70</u>	<u>140</u>
<u>Blue Clay</u>	<u>140</u>	<u>180</u>
<u>gray sand</u>	<u>180</u>	<u>210</u>
<u>Blue shale</u>	<u>210</u>	<u>300</u>
<u>Blue sand</u>	<u>300</u>	<u>350</u>

(mailing address)

WELL LOCATION:  
 sec. 23 T. 4 N R. 18 E  
 S W  
1 miles S of Henlyfield  
 (distance) (direction) (nearest town)

WELL PURPOSE: Home  
 (home, irrigation, municipal, industrial)

WELL COMPLETION DATA:

- (1) diameter (inches) 4
- (2) total depth (feet) 350
- (3) static water level (feet) 90 below above top of ground.
- (4) casing PVC 340  
 (material) (depth)
- (size) if telescope see back.
- (5) screen 10 340  
 (length) (depth to top)
- (size) (material) PVC
- (6) pump 3/4 1100  
 (HP) (yield gpm)
- (type power) elec
- (7) electric log \_\_\_\_\_  
 (yes or no)

(organization running log)

(8) how well bottom plugged and  
shut

DRILLERS REMARKS:


DEPT. OF NATURAL RESOURCES  
 BUREAU OF LAND & WATER RESOURCES

NOV 9 1981

RECEIVED

If well telescopes please sketch and show depths.

GROUND LEVEL

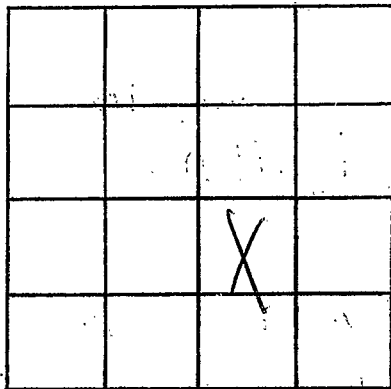

SECTION \_\_\_\_\_

Please indicate well location X.

ADDITIONAL INFORMATION

If more than one screen,  
show locations of each on sketch.