

MISSISSIPPI DEPARTMENT OF NATURAL RESOURCES

Bureau of Land and Water Resources

Southport Mall

P.O. Box 10631

Jackson, Mississippi 39209

WATER WELL DRILLERS LOG

Pearl River
 # 2043
 9-10-81

9-10-81
 date well completed

BUD PENTON & SON
 WATER WELL SERVICE
 ROUTE #111 Home #41
 CARRIERE, MS 39426
 PHONE 798-5324

Pearl River
 county well located

LANDOWNER: Joe Guco
 Henly field ms.

description of formations encountered	from	to
Red shale	0	25
Red sand	25	85

(mailing address)
 WELL LOCATION:
 sec. 36 T 4 N R 18 E
 3 miles N of Cybur
 (distance) (direction) (nearest town)

WELL PURPOSE: Home
 (home, irrigation, municipal, industrial)

- WELL COMPLETION DATA:
- (1) diameter (inches) 4
 - (2) total depth (feet) 85
 - (3) static water level (feet) 35 below top of ground.
 - (4) casing PVC, 75 (material), (depth)
 - (5) screen 10 (length), 75 (depth to top), 4 (size), PVC (material)
 - (6) pump 1/2 (HP), 800 (yield gpm), elec (type power)
 - (7) electric log (yes or no)

(organization running log)
 (8) how well bottom plugged

DRILLERS REMARKS:

RECEIVED
 NOV 9 1981
 4:51


DEPT. OF NATURAL RESOURCES
 BUREAU OF LAND & WATER RESOURCES

NOV 9 - 1981

RECEIVED

If well telescopes please sketch and show depths.

GROUND LEVEL

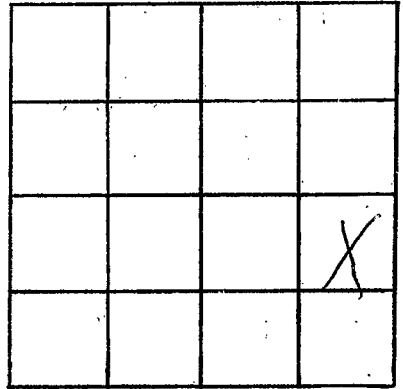

SECTION _____

Please indicate well location X.

ADDITIONAL INFORMATION

If more than one screen,
show locations of each on sketch.