

MISSISSIPPI DEPARTMENT OF NATURAL RESOURCES

Bureau of Land and Water Resources

Southport Mall

P.O. Box 10631

Jackson, Mississippi 39209

WATER WELL DRILLERS LOG

Pearl River
 # 2044
 9-15-81

Sept 15 19 81 - Walbers Welding & Repair Pearl River
 date well completed firm name county well located
 Billy C Walber

LANDOWNER:	description of formations encountered	from	to
New Wesleyfield Baptist Ch Rt 1 Carriere Miss. 39426 (mailing address)	Red shale Red sand White sand coarse sand fine gravel	0 28 43 53	28 43 53 81
WELL LOCATION: sec. 24 T 4 S R 15 W 15 miles N-W of Bayoune (distance) (direction) (nearest town)			
WELL PURPOSE: Home Church (home, irrigation, municipal, industrial)			
WELL COMPLETION DATA: (1) diameter (inches) 4" (2) total depth (feet) 81" (3) static water level (feet) 58 below top of ground. (4) casing PVC, 80' (material) (depth) (size) if telescope see back. (5) screen 10' 71' (length) (depth to top) #12 PVC (size) (material) (6) pump 1/2 8 (HP) (yield gpm) elect. (type power) (7) electric log no (yes or no) (organization running log) (8) how well bottom plugged Sand above			
DRILLERS REMARKS:			


DEPT. OF NATURAL RESOURCES
 BUREAU OF LAND & WATER RESOURCES

OCT - 6 1981

RECEIVED

If well telescopes please sketch and show depths.

GROUND LEVEL

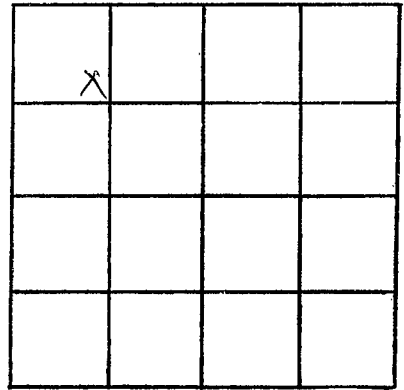

SECTION _____

Please indicate well location X.

ADDITIONAL INFORMATION

If more than one screen,
show locations of each on sketch.