

MISSISSIPPI DEPARTMENT OF NATURAL RESOURCES

Bureau of Land and Water Resources

Southport Mall

P.O. Box 10631

Jackson, Mississippi 39209

WATER WELL DRILLERS LOG

Pearl River
 2045
 8-21-81

8-21-1981 date well completed
 81 Bud Pata & Son firm name
 P.R. county well located

LANDOWNER: Jack Regan
Herby Hill Mo.
 (mailing address)
 WELL LOCATION:
 sec 36 T 4 N R 18 E
2 miles N of Cyber
 (distance) (direction) (nearest town)

description of formations encountered	from	to
gray shale	0	20'
light gray sand	20	35'
Blue shale	35	160
Blue sand	160	225
Blue shale	225	250
Blue shale	250	517

WELL PURPOSE: Home
 (home, irrigation, municipal, industrial)

- WELL COMPLETION DATA:
- (1) diameter (inches) 4" x 2"
 - (2) total depth (feet) 517
 - (3) static water level (feet) 45 below top of ground.
 - (4) casing PVC 517
 (material) (depth)
 - _____ if telescope see back.
 (size)
 - (5) screen 10' 510
 (length) (depth to top)
2" PVC
 (size) (material)
 - (6) pump 1 1200
 (HP) (yield gpm)
etc
 (type power)
 - (7) electric log _____
 (yes or no)

_____ (organization running log)

(8) how well bottom plugged Sept
Shub

DRILLERS REMARKS: _____


DEPT. OF NATURAL RESOURCES
 BUREAU OF LAND & WATER RESOURCES

NOV 9 - 1981

RECEIVED

If well telescopes please sketch and show depths.

GROUND LEVEL

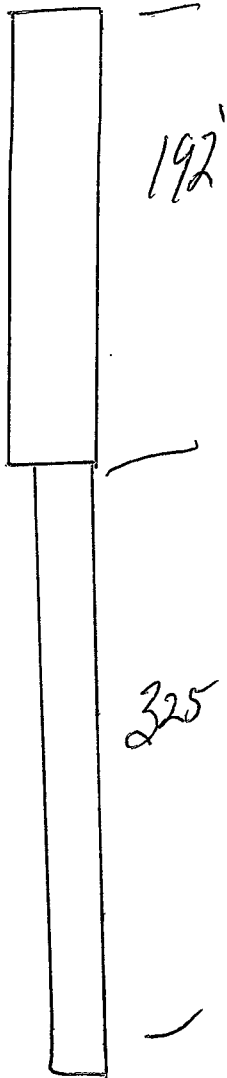

			X

SECTION _____

Please indicate well location X.

ADDITIONAL INFORMATION

If more than one screen, show locations of each on sketch.