

MISSISSIPPI DEPARTMENT OF NATURAL RESOURCES

Bureau of Land and Water Resources

Southport Mall

P.O. Box 10631

Jackson, Mississippi 39209

WATER WELL DRILLERS LOG

Walkers Welding &
Repair Shop

Pearl River
county well located

Pearl River
Φ 2046
10-15-81

Oct 15 1981
date well completed

firm name

LANDOWNER: Ed Saulson
Rt 1 Carrine Miss
(mailing address)

description of formations encountered

from

to

red sandy clay	1	54
Red gravel	54	60
course white sand	68	80

WELL LOCATION:
sec. 39 T 4 N R. 13 E
S W
14 miles NE of Bicayne
(distance) (direction) (nearest town)

WELL PURPOSE: Home
(home, irrigation, municipal, industrial)

WELL COMPLETION DATA:

- (1) diameter (inches) 4"
- (2) total depth (feet) 80
- (3) static water level (feet) 50 below top of ground.
- (4) casing 4" PVC, 80'
(material) (depth)
(size) If telescope see back.
- (5) screen 10", 70'
(length) (depth to top)
(size) PVC (material)
- (6) pump 1/2 7 1/2 gal
(HP) (yield gpm)
electric (type power)
- (7) electric log (yes or no) _____

(organization running log) _____

(8) how well bottom plugged sand shark

DRILLERS REMARKS: _____


DEPT. OF NATURAL RESOURCES
BUREAU OF LAND & WATER RESOURCES

NOV 10 1981

RECEIVED

If well telescopes please sketch and show depths.

GROUND LEVEL

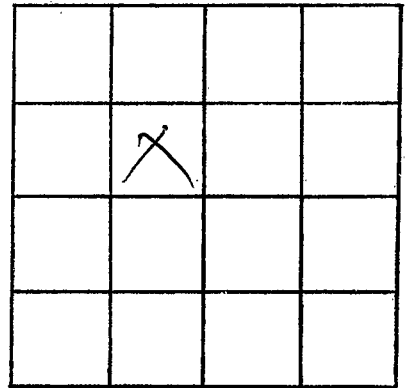

SECTION _____

Please indicate well location X.

ADDITIONAL INFORMATION

If more than one screen,
show locations of each on sketch.