

MISSISSIPPI DEPARTMENT OF NATURAL RESOURCES

Bureau of Land and Water Resources

Southport Mall

P.O. Box 10631

Jackson, Mississippi 39209

WATER WELL DRILLERS LOG

Pearl River  
Ø 2047  
10-17-81

Walker Welding & Repair Shop  
 firm name

Pearl River  
 county well located

Oct 17 1981  
 date well completed

LANDOWNER: <u>Hanlyfield</u> <u>Vol. Fire Dept.</u>	description of formations encountered	from	to
<u>RT#1</u> <u>Carrier Miss 39426</u> (mailing address)	<u>Red shale</u> <u>Coarse sand &amp; gravel</u> <u>big gravel</u>	<u>1</u> <u>35</u> <u>35</u>	<u>35</u> <u>35</u> <u>37</u>
WELL LOCATION:			
sec. <u>13</u> T. <u>4</u> N. R. <u>18</u> E. to Hwy <u>43</u> - <u>Healyfield</u> W <u>14</u> miles <u>N.W.</u> of <u>Picayune</u> (distance) (direction) (nearest town)			
WELL PURPOSE: <u>Fire Dept.</u> (home, irrigation, municipal, industrial)			
WELL COMPLETION DATA:			
(1) diameter (inches) <u>4"</u>			
(2) total depth (feet) <u>87'</u>			
(3) static water level (feet) <u>58</u> below top of ground. <u>surface</u>			
(4) casing <u>4" PVC</u> , <u>877'</u> (material) (depth)			
(size) if telescope see back.			
(5) screen <u>10'</u> , <u>77'</u> (length) (depth to top)			
<u>12</u> , <u>PVC</u> (size) (material)			
(6) pump <u>No</u> (HP) (yield gpm)			
(type power)			
(7) electric log (yes or no)			
(organization running log)			
(8) how well bottom plugged <u>Sand</u> <u>plug</u>			
DRILLERS REMARKS:			


DEPT. OF NATURAL RESOURCES  
 BUREAU OF LAND & WATER RESOURCES

NOV 10 1981

RECEIVED

If well telescopes please sketch and show depths.

GROUND LEVEL

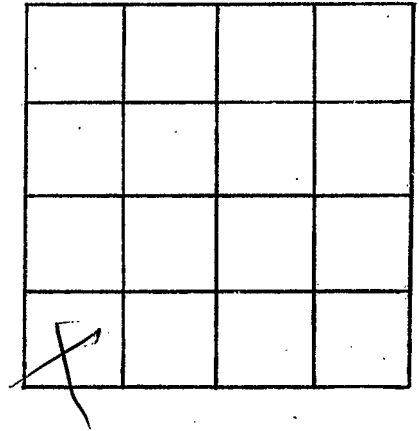

SECTION \_\_\_\_\_

Please indicate well location X.

ADDITIONAL INFORMATION

If more than one screen,  
show locations of each on sketch.