

Real River  
02018

MISSISSIPPI DEPARTMENT OF NATURAL RESOURCES  
 Bureau of Land and Water Resources  
 Southport Mall  
 P.O. Box 10631  
 Jackson, Mississippi 39209  
**WATER WELL DRILLERS LOG**

Feb 9 1982 Walker Welding Real River  
 date well completed firm name county well located

LANDOWNER: Raymond Fleming  
R1 Cameron Miss  
 (mailing address)

description of formations encountered	from	to
<u>Red shale</u>	<u>1</u>	<u>54</u>
<u>fine sand</u>	<u>54</u>	<u>65</u>
<u>course sand / silt</u>	<u>65</u>	<u>82</u>

WELL LOCATION:  
 sec. 23 T 4 N R. 18 E  
15 miles SW of Prichard  
 (distance) (direction) (nearest town)

WELL PURPOSE: Artesian  
 (home, irrigation, municipal, industrial)

- WELL COMPLETION DATA:
- (1) diameter (inches) 4"
  - (2) total depth (feet) 82'
  - (3) static water level (feet) 65' below top of ground.
  - (4) casing PVC, 72' (material), (depth)  
 (size) if telescope see back.
  - (5) screen 10', 72' (length), (depth to top)  
12, PVC (size), (material)
  - (6) pump Elect, 5 (HP), (yield gpm)  
Elect (type power)
  - (7) electric log (yes or no)
- (organization running log)


(8) how well bottom plugged hard as rock

DRILLERS REMARKS:

MISSISSIPPI DEPARTMENT OF NATURAL RESOURCES  
 BUREAU OF LAND AND WATER RESOURCES  
 RECEIVED  
 FEB 24 1982

If well telescopes please sketch and show depths.

GROUND LEVEL

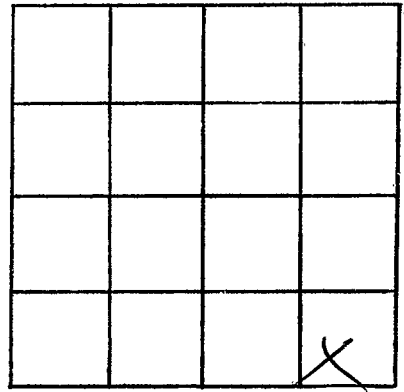

SECTION \_\_\_\_\_

Please indicate well location X.

ADDITIONAL INFORMATION

If more than one screen,  
show locations of each on sketch.