

MISSISSIPPI DEPARTMENT OF NATURAL RESOURCES

Bureau of Land and Water Resources

Southport Mall

P.O. Box 10631

Jackson, Mississippi 39209

WATER WELL DRILLERS LOG

Paul River  
0  
2049

8-8-82 19 Walker Welding Paul River  
 date well completed firm name county well located

LANDOWNER: JA Duvivier  
20533 Alta E Vondra  
New Orleans La  
 (mailing address)

description of formations encountered	from	to
Red shale	0	18
fine sand	18	30
medium sand	30	52
white shell	52	85
sand gravel	85	118

WELL LOCATION:  
 sec 25 T 4 N R 18 E  
17 miles NW Prichard  
 (distance) (direction) (nearest town)

WELL PURPOSE: Home  
 (home, irrigation, municipal, industrial)

- WELL COMPLETION DATA:
- (1) diameter (inches) 4"
  - (2) total depth (feet) 118'
  - (3) static water level (feet) 63 below top of ground.
  - (4) casing PVC, 108  
 (material) (depth)  
 (size) if telescope see back.
  - (5) screen 10', 108  
 (length) (depth to top)  
15, PVC  
 (size) (material)
  - (6) pump 1/2, 8  
 (HP) (yield gpm)  
Elec  
 (type power)
  - (7) electric log yes or no  
 (organization running log)
  - (8) how well bottom plugged sand


DRILLERS REMARKS:

DEPT. OF NATURAL RESOURCES  
 BUREAU OF LAND & WATER RESOURCES

MAY 10 1982  
 RECEIVED

If well telescopes please sketch and show depths.

GROUND LEVEL

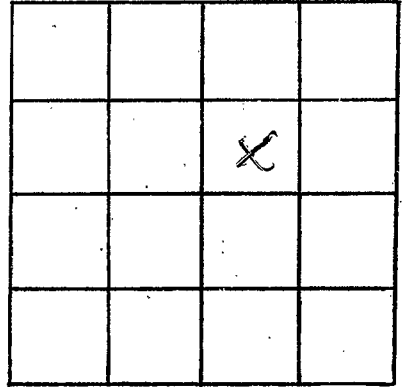

SECTION \_\_\_\_\_

Please indicate well location X.

ADDITIONAL INFORMATION

If more than one screen,  
show locations of each on sketch.