

MISSISSIPPI DEPARTMENT OF NATURAL RESOURCES

Bureau of Land and Water Resources

Southport Mall

P.O. Box 10631

Jackson, Mississippi 39209

WATER WELL DRILLERS LOG

Pearl River
0
2050

4-12-82 19 Walker Well Pearl River
 date well completed firm name county well located


LANDOWNER: <u>Craigton Burnett</u> <u>Burnett</u>	Description of formations encountered	from	to
<u>R1</u> <u>Cameron Springs</u> (mailing address)	<u>Red shell</u>	<u>0</u>	<u>36</u>
WELL LOCATION: sec. <u>14</u> T <u>4</u> N R <u>18</u> S	<u>fine sand</u>	<u>36</u>	<u>54</u>
<u>20</u> miles <u>NW</u> of <u>Pearson</u> (distance) (direction) (nearest town)	<u>Blue shale</u>	<u>54</u>	<u>136</u>
WELL PURPOSE: <u>Home</u> (home, irrigation, municipal, industrial)	<u>and lignite</u>	<u>136</u>	<u>162</u>
WELL COMPLETION DATA:			
(1) diameter (inches) <u>4"</u>			
(2) total depth (feet) <u>162'</u>			
(3) static water level (feet) <u>100</u> below top of ground.			
(4) casing <u>PVC</u> , <u>152'</u> (material) (depth)			
(size) if telescope see back.			
(5) screen <u>10'</u> , <u>152'</u> (length) (depth to top)			
<u>12</u> , <u>PVC</u> (size) (material)			
(6) pump <u>1/2</u> , <u>5</u> (HP) (yield gpm)			
<u>Electric</u> (type power)			
(7) electric log (yes or no)			
(organization running log)			
(8) how well bottom plugged <u>round</u> <u>sharp</u>			
DRILLERS REMARKS:			

DEPT. OF NATURAL RESOURCES
 BUREAU OF LAND & WATER RESOURCES

MAY 10 1982
 RECEIVED

If well telescopes please sketch and show depths.

GROUND LEVEL

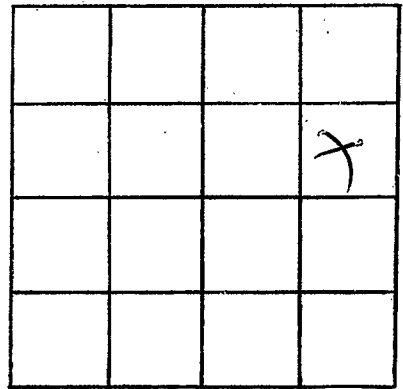

SECTION _____

Please indicate well location X.

ADDITIONAL INFORMATION

If more than one screen, show locations of each on sketch.