

MISSISSIPPI DEPARTMENT OF NATURAL RESOURCES

Bureau of Land and Water Resources

Southport Mall

P.O. Box 10631

Jackson, Mississippi 39209

WATER WELL DRILLERS LOG

Pearl River  
0  
2051

5/82 date well completed    Walker Well and Pearl River Co. firm name    county well located

LANDOWNER: Howard Roden

description of formations encountered	from	to
<u>red shale</u>	<u>0</u>	<u>57</u>
<u>sand</u>	<u>57</u>	<u>70</u>
<u>blue shale</u>	<u>70</u>	<u>200</u>
<u>sand</u>	<u>200</u>	<u>205</u>
<u>blue shale</u>	<u>205</u>	<u>362</u>
<u>sandstone</u>	<u>362</u>	<u>390</u>

RT1  
Carrico, Miss  
 (mailing address)

WELL LOCATION:  
<sup>38</sup> sec 4 T 4 N R 18 E  
 S W  
15 miles NW of Pearl River  
 (distance) (direction) (nearest town)

WELL PURPOSE: home  
 (home, irrigation, municipal, industrial)

WELL COMPLETION DATA:


- (1) diameter (inches) 4
- (2) total depth (feet) 390
- (3) static water level (feet) 189 below top of ground.
- (4) casing PVC 375  
 (material) (depth)
- 2x4 if telescope see back.  
 (size)
- (5) screen 15 375  
 (length) (depth to top)
- 12 PVC  
 (size) (material)
- (6) pump 1 8  
 (HP) (yield gpm)
- Elec  
 (type power)
- (7) electric log (yes or no) \_\_\_\_\_  
 (organization running log) \_\_\_\_\_
- (8) how well bottom plugged SAND  
SHARP

DRILLERS REMARKS: \_\_\_\_\_


RECEIVED  
 MAY 17 1992  
 MISSISSIPPI DEPARTMENT OF NATURAL RESOURCES  
 BUREAU OF LAND AND WATER RESOURCES

If well telescopes please sketch and show depths.

GROUND LEVEL

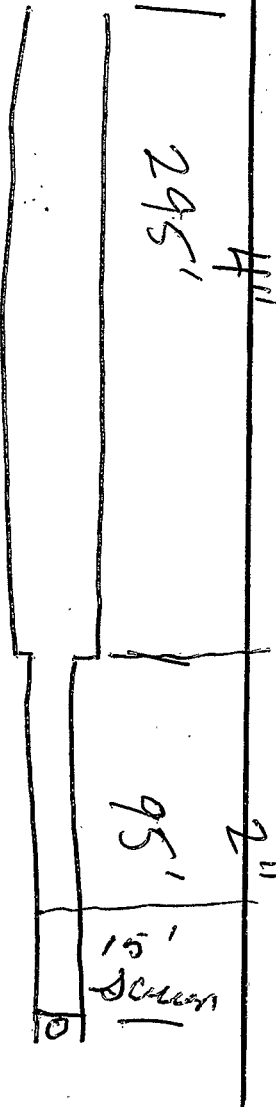

If more than one screen, show locations of each on sketch.

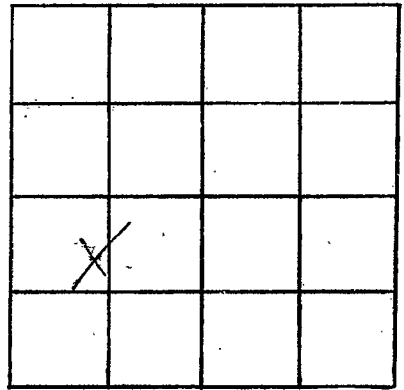

SECTION \_\_\_\_\_

Please indicate well location X.

ADDITIONAL INFORMATION

Lined area for additional information.