

MISSISSIPPI DEPARTMENT OF NATURAL RESOURCES

Bureau of Land and Water Resources

Southport Mall

P.O. Box 10631

Jackson, Mississippi 39209

WATER WELL DRILLERS LOG

Red River
0
2052

June 28 1982 Walker Wellboring Pearl River
 date well completed firm name county well located

LANDOWNER: <u>Jewell Burnett</u>	description of formations encountered	from	to
<u>P. I. Cannon's mess</u> (mailing address)	<u>Red shale</u> <u>Coarse sand</u> <u>fine gravel</u>	<u>0</u> <u>46</u>	<u>46</u> <u>72</u>
WELL LOCATION: sec. <u>13</u> T. <u>4</u> N. R. <u>18</u> E. <u>18</u> miles <u>NW</u> of <u>Henryfield</u> (distance) (direction) (nearest town)			
WELL PURPOSE: <u>Dom</u> (home, irrigation, municipal, industrial)			
WELL COMPLETION DATA:			
(1) diameter (inches) <u>4"</u>			
(2) total depth (feet) <u>72'</u>			
(3) static water level (feet) <u>46</u> below above top of ground.			
(4) casing <u>PVC</u> , <u>62'</u> (material) (depth)			
(size) If telescope see back.			
(5) screen <u>10</u> , <u>62"</u> (length) (depth to top)			
<u>12</u> , <u>PVC</u> (size) (material)			
(6) pump <u>1/2</u> , <u>10</u> (HP) (yield gpm)			
<u>Elec</u> (type power)			
(7) electric log (yes or no) (organization running log)			
(8) how well bottom plugged <u>Sand</u> <u>shrub</u>			
DRILLERS REMARKS:			


DEPT. OF NATURAL RESOURCES
 BUREAU OF LAND & WATER RESOURCES

JUL 20 1982

RECEIVED

If well telescopes please
sketch and show depths.

GROUND LEVEL

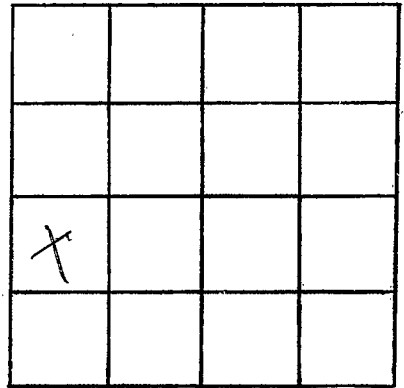

SECTION _____

Please indicate well location X.

ADDITIONAL INFORMATION

If more than one screen,
show locations of each on sketch.