

MISSISSIPPI DEPARTMENT OF NATURAL RESOURCES

Bureau of Land and Water Resources

Southport, Mississippi  
 P.O. Box 10631  
 Jackson, Mississippi 39209

BUD PENTON & SON  
 WATER WELL SERVICE  
 ROUTE BOX  
 CARRIERS, MS 39426  
 PHONE 798-5324

WATER WELL DRILLERS LOG  
 ROUTE BOX  
 CARRIERS, MS 39426  
 PHONE 798-5324

Real River  
O 2054

9/24 1982  
 date well completed

Real River  
 county well located

LANDOWNER: Ralph Ferguson

description of formations encountered	from	to
<u>Red Spale</u>	<u>0</u>	<u>12</u>
<u>Red Sand</u>	<u>12</u>	<u>35</u>
<u>Blue Shaly</u>	<u>35</u>	<u>265</u>
<u>Blue Sand</u>	<u>265</u>	<u>350</u>
<u>Blue Shaly</u>	<u>350</u>	<u>410</u>
<u>Gray Sand</u>	<u>410</u>	<u>450</u>

R.T.3 Carriere miss.

(mailing address)

WELL LOCATION:

sec. 14 T. 4 N. R. 18 E.  
 S. W.  
12 miles NW of Carriere  
 (distance) (direction) (nearest town)

WELL PURPOSE: home  
 (home, irrigation, municipal, industrial)

WELL COMPLETION DATA:

- (1) diameter (inches) 4"
- (2) total depth (feet) 450
- (3) static water level (feet) 110 below above top of ground.
- (4) casing PVC, 450  
(material) (depth)
- (size) If telescope see back.
- (5) screen 2x13, 435  
(length) (depth to top)
- 12, PVC  
(size) (material)
- (6) pump 1, 1350  
(HP) (yield gpm)
- elect  
(type power)
- (7) electric log no  
(yes or no)

(organization running log)

(8) how well bottom plugged land  
shark

DRILLERS REMARKS:


DEPT. OF NATURAL RESOURCES  
 BUREAU OF LAND & WATER RESOURCES

DEC - 1 1982

RECEIVED

If well telescopes please sketch and show depths.

GROUND LEVEL

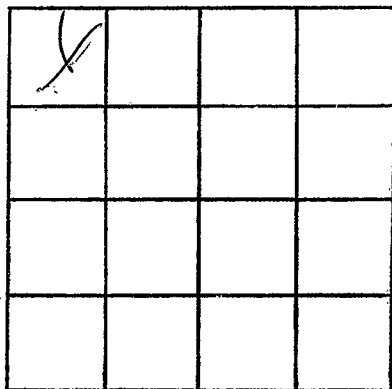

SECTION \_\_\_\_\_

Please indicate well location X.

ADDITIONAL INFORMATION

If more than one screen,  
show locations of each on sketch.