

MISSISSIPPI DEPARTMENT OF NATURAL RESOURCES

Bureau of Land and Water Resources

Southport Mall

P.O. Box 10631

Jackson, Mississippi 39209

WATER WELL DRILLERS LOG

Pearl River
02056

3-15 1982 Walker Welding Pearl River
date well completed firm name county well located

LANDOWNER: <u>Tony Pope</u>	description of formations encountered	from	to
<u>A-1 carrier spin</u> (mailing address)	<u>Red sandy clay</u>	<u>0</u>	<u>27</u>
	<u>Red shale</u>	<u>27</u>	<u>70</u>
	<u>fine sand</u>	<u>70</u>	<u>85</u>
	<u>Blue shale</u>	<u>85</u>	<u>240</u>
	<u>Sand</u>	<u>240</u>	<u>290</u>
WELL LOCATION: sec <u>39</u> T <u>4</u> N R <u>18</u> E S W <u>14</u> miles <u>NW</u> <u>Prichard</u> (distance) (direction) (nearest town)			
WELL PURPOSE: <u>Home</u> (home, irrigation, municipal, industrial)			
WELL COMPLETION DATA:			
(1) diameter (inches) <u>2"</u>			
(2) total depth (feet) <u>290</u>			
(3) static water level (feet) <u>85</u> below top of ground. depth			
(4) casing <u>PVC</u> , <u>280</u> , (material) (depth)			
(size) if telescope see back.			
(5) screen <u>10'</u> , <u>280</u> (length) (depth to top)			
<u>12</u> , <u>PVC</u> (size) (material)			
(6) pump <u>1</u> <u>7</u> (HP) (yield gpm)			
<u>Elec</u> (type power)			
(7) electric log (yes or no)			
(organization running log)			
(8) how well bottom plugged <u>Drilled</u> <u>sharp</u>			
DRILLERS REMARKS:			


DEPT. OF NATURAL RESOURCES
BUREAU OF LAND & WATER RESOURCES

APR 6 1982

RECEIVED

If well telescopes please sketch and show depths.

GROUND LEVEL

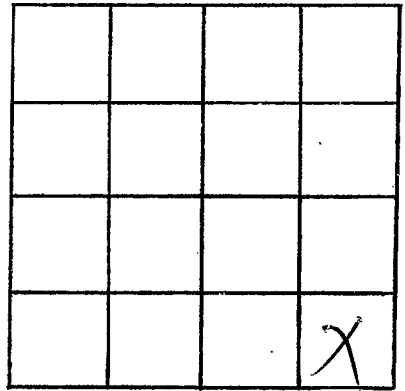

SECTION _____

Please indicate well location X.

ADDITIONAL INFORMATION

If more than one screen,
show locations of each on sketch.