

MISSISSIPPI DEPARTMENT OF NATURAL RESOURCES

Bureau of Land and Water Resources

Southport Mall

P.O. Box 10631

Jackson, Mississippi 39209

WATER WELL DRILLERS LOG

Pearl River
02057

Oct 20 1982
 date well completed

Walker Welding
 firm name

Pearl River
 county well located

LANDOWNER: Mr. Ingersoll
336 N. St. Patrick Street
New Orleans La.
 (mailing address)

description of formations encountered	from	to
<u>Red shale</u>	<u>0</u>	<u>14</u>
<u>Sand</u>	<u>14</u>	<u>20</u>
<u>Blue shale</u>	<u>20</u>	<u>210</u>
<u>Sand & gravel</u>	<u>210</u>	<u>254</u>

WELL LOCATION:

sec. 13 T 4 N R. 18 W
Monroeville
 (distance) miles (direction) of (nearest town)

WELL PURPOSE: Home
 (home, irrigation, municipal, industrial)

WELL COMPLETION DATA:

- (1) diameter (inches) 4"
- (2) total depth (feet) 254
- (3) static water level (feet) 175 below top of ground.
- (4) casing PVC, 254,
 (material) (depth)

(size) If telescope see back.

- (5) screen 10' 244'
 (length) (depth to top)
15 PVC
 (size) (material)

- (6) pump 1/2 8
 (HP) (yield gpm)

Elec
 (type power)

- (7) electric log (yes or no)

(organization running log)

- (8) how well bottom plugged Sand
to pack

DRILLERS REMARKS:


DEPT. OF NATURAL RESOURCES
 BUREAU OF LAND & WATER RESOURCES

NOV - 1 1982

RECEIVED

If well telescopes please
sketch and show depths.

GROUND LEVEL

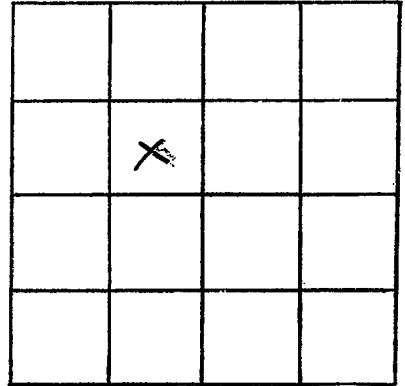

SECTION _____

Please indicate well location X.

ADDITIONAL INFORMATION

If more than one screen,
show locations of each on sketch.