

MISSISSIPPI DEPARTMENT OF NATURAL RESOURCES

Bureau of Land and Water Resources

Southport Mall

P.O. Box 10631

Jackson, Mississippi 39209

WATER WELL DRILLERS LOG

BUD PENTON & SON  
WATER WELL SERVICE  
ROUTE 4 BOX 402  
CARRIERS, MS 39426  
PHONE 798-5324

Paul River  
2058  
0

8/30 1982  
date well completed

Paul River  
county well located

LANDOWNER: <u>Prosser Farm</u>	description of formations encountered	from	to
<u>R.T. H. Carriere</u>	<u>Red Shell</u> <u>Red Sand</u>	<u>0</u> <u>30</u>	<u>30</u> <u>90</u>
(mailing address)			
WELL LOCATION:			
sec. <u>36</u> T. <u>4</u> N R. <u>18</u> E S W <u>6</u> miles <u>E</u> of <u>Carriere</u> (distance) (direction) (nearest town)			
WELL PURPOSE: <u>Drilled</u> (home, irrigation, municipal, industrial)			
WELL COMPLETION DATA:			
(1) diameter (inches) <u>2 1/2"</u>			
(2) total depth (feet) <u>90 ft.</u>			
(3) static water level (feet) <u>32</u> below above top of ground.			
(4) casing <u>PVC</u> <u>90</u> (material) (depth) <u>no</u> if telescope see back. (size)			
(5) screen <u>4" x 10</u> <u>80</u> (length) (depth to top) <u>12</u> <u>PVC</u> (size) (material)			
(6) pump <u>1/2</u> <u>650</u> (HP) (yield gpm) <u>Elect.</u> (type power)			
(7) electric log <u>no</u> (yes or no)  (organization running log)			
(8) how well bottom plugged <u>hard</u> <u>short</u>			
DRILLERS REMARKS:			


DEPT. OF NATURAL RESOURCES  
BUREAU OF LAND & WATER RESOURCES

DEC - 1 1982

RECEIVED

If well telescopes please sketch and show depths.

GROUND LEVEL

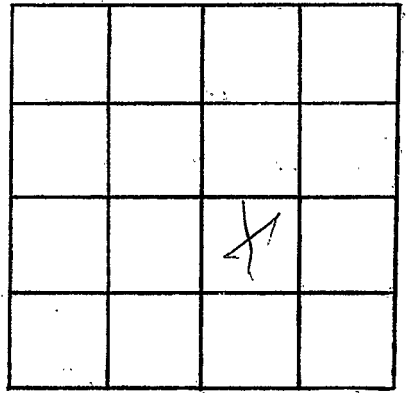

SECTION \_\_\_\_\_

Please indicate well location X.

ADDITIONAL INFORMATION

If more than one screen,  
show locations of each on sketch.