

MISSISSIPPI DEPARTMENT OF NATURAL RESOURCES

Bureau of Land and Water Resources

Southport Mall

P.O. Box 10631

Jackson, Mississippi 39209

WATER WELL DRILLERS LOG

Paul Ruxer  
02059

Jan 5 1983 Walker Well Drilling Paul Ruxer  
date well completed firm name county well located

LANDOWNER: <u>David Burge</u>	description of formations encountered	from	to
<u>Al Canine Miss</u>  (mailing address)	<u>Red shale</u> <u>sand</u>	<u>0</u> <u>16</u>	<u>16</u> <u>82</u>
<b>WELL LOCATION:</b>			
sec. <u>27</u> T <u>4</u> S R. <u>18</u> W <u>15</u> miles <u>NW</u> <u>De Ridgeland</u> (distance) (direction) (nearest town)			
<b>WELL PURPOSE:</b> <u>Home</u> (home, irrigation, municipal, industrial)			
<b>WELL COMPLETION DATA:</b>			
(1) diameter (inches) <u>11"</u>			
(2) total depth (feet) <u>82'</u>			
(3) static water level (feet) <u>58'</u> below top of ground.			
(4) casing <u>PVC</u> <u>82'</u> (material) (depth)			
_____ if telescope see back. (size)			
(5) screen <u>10'</u> <u>72'</u> (length) (depth to top)			
<u>12</u> <u>PVC</u> (size) (material)			
(6) pump <u>1</u> <u>8</u> (HP) (yield gpm)			
<u>elec</u> (type power)			
(7) electric log _____ (yes or no)			
_____ (organization running log)			
(8) how well bottom plugged <u>sand</u> <u>shock</u>			
DRILLERS REMARKS: _____			


DEPT. OF NATURAL RESOURCES  
BUREAU OF LAND & WATER RESOURCES

JAN 17 1983

RECEIVED

If well telescopes please  
sketch and show depths.

GROUND LEVEL

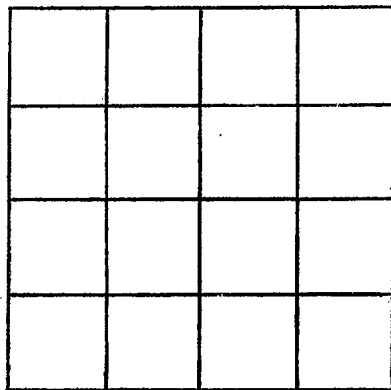

SECTION \_\_\_\_\_

Please indicate well location X.

ADDITIONAL INFORMATION

If more than one screen,  
show locations of each on sketch.