

MISSISSIPPI DEPARTMENT OF NATURAL RESOURCES

Bureau of Land and Water Resources

Southport Mall

P.O. Box 10631

Jackson, Mississippi 39209

WATER WELL DRILLERS LOG

Pearl River
02060

Feb 8 - 83 19 Walkers Well Drilling Pearl River
 date well completed firm name county well located

LANDOWNER: <u>Ch Home Co.</u>	description of formations encountered	from	to
<u>Louis Di Benedetto</u>	<u>Red shale</u>	<u>0</u>	<u>36</u>
<u>516 Woodlawn Lane, Hattiesburg, MS</u> (mailing address) <u>7023</u>	<u>Sand pin head</u>	<u>36</u>	<u>52</u>
WELL LOCATION: <u>Hentzfield</u>			
sec. <u>13</u> T <u>4</u> N R <u>18</u> E S W			
<u>1.5</u> miles <u>NW</u> <u>Pearl River</u> (distance) (direction) (nearest town)			
WELL PURPOSE: <u>Home</u> (home, irrigation, municipal, industrial)			
WELL COMPLETION DATA:			
(1) diameter (inches) <u>4"</u>			
(2) total depth (feet) <u>52</u>			
(3) static water level (feet) <u>32</u> below top of ground. above			
(4) casing <u>PVC</u> <u>42'</u> (material) (depth)			
_____ if telescope see back. (size)			
(5) screen <u>10'</u> <u>42'</u> (length) (depth to top)			
<u>12</u> <u>PVC</u> (size) (material)			
(6) pump <u>1/4</u> <u>10</u> (HP) (yield gpm)			
<u>Electric</u> (type power)			
(7) electric log _____ (yes or no)			
_____ (organization running log)			
(8) how well bottom plugged <u>Soft</u> <u>slack</u>			
DRILLERS REMARKS:			


DEPT. OF NATURAL RESOURCES
 BUREAU OF LAND & WATER RESOURCES

FEB 22 1983

RECEIVED

If well telescopes please sketch and show depths.

GROUND LEVEL

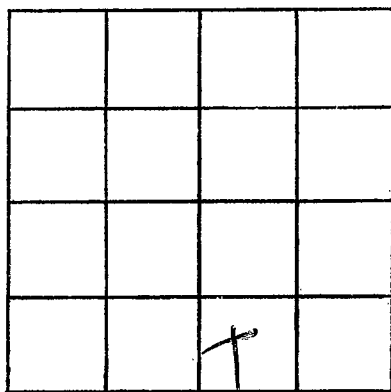

SECTION _____

Please indicate well location X.

ADDITIONAL INFORMATION

If more than one screen,
show locations of each on sketch.