

**MISSISSIPPI DEPARTMENT OF NATURAL RESOURCES**  
**Bureau of Land and Water Resources**  
 Southport Mall  
 P.O. Box 10631  
 Jackson, Mississippi 39209  
**WATER WELL DRILLERS LOG**

Pearl River  
00002

Feb 11-83 19 Walker Welding Pearl River  
 date well completed firm name county well located

LANDOWNER: <u>Charles R Purvis</u>	description of formations encountered	from	to
<u>R1 Carnine Miss</u>	<u>Red shale</u>	<u>0</u>	<u>36</u>
<u>Hensleyfield</u> (mailing address)	<u>Sand Fine Gravel</u>	<u>36</u>	<u>65</u>
<b>WELL LOCATION:</b>			
sec. <u>11</u> T <u>4</u> N R <u>18</u> E S W <u>15</u> miles <u>NW</u> of <u>Pearl River</u> (distance) (direction) (nearest town)			
<b>WELL PURPOSE:</b> <u>Home</u> (home, irrigation, municipal, industrial)			
<b>WELL COMPLETION DATA:</b>			
(1) diameter (inches) <u>4"</u>			
(2) total depth (feet) <u>65'</u>			
(3) static water level (feet) <u>42</u> below above top of ground.			
(4) casing <u>PVC</u> <u>55'</u> (material) (depth)			
_____ if telescope see back. (size)			
(5) screen <u>10'</u> <u>55'</u> (length) (depth to top)			
(6) pump <u>12</u> <u>PVC</u> (size) (material)			
(6) pump <u>1/2</u> <u>14</u> (HP) (yield gpm)			
<u>Elec</u> (type power)			
(7) electric log _____ (yes or no)			
_____ (organization running log)			
(8) how well bottom plugged <u>Good</u> <u>Clay</u>			
DRILLERS REMARKS: _____			


DEPT. OF NATURAL RESOURCES  
 BUREAU OF LAND & WATER RESOURCES

FEB 22 1983

**RECEIVED**

If well telescopes please  
sketch and show depths.

GROUND LEVEL

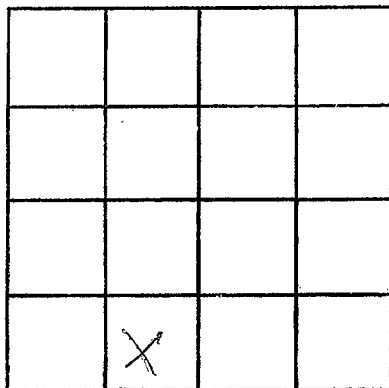

SECTION \_\_\_\_\_

Please indicate well location X.

ADDITIONAL INFORMATION

If more than one screen,  
show locations of each on sketch.