

MISSISSIPPI DEPARTMENT OF NATURAL RESOURCES

Bureau of Land and Water Resources

Southport Mall

P.O. Box 10631

Jackson, Mississippi 39209

WATER WELL DRILLERS LOG

Pearl River
02063

June 2 1983 Walton Holding Pearl River
 date well completed firm name county well located

LANDOWNER:	description of formations encountered	from	to
<u>Steve Harper</u> <u>RI Courier Miss</u> (mailing address)			
WELL LOCATION: sec <u>23</u> T <u>4</u> N R <u>18</u> E <u>S</u> <u>W</u> <u>Harleyfield</u> (distance) miles (direction) of (nearest town)	<u>Sandy gravel</u>	<u>16</u>	<u>61</u>
WELL PURPOSE: <u>Home</u> (home, irrigation, municipal, industrial)			
WELL COMPLETION DATA:			
(1) diameter (inches) <u>4"</u>			
(2) total depth (feet) <u>61'</u>			
(3) static water level (feet) <u>35</u> below above top of ground.			
(4) casing <u>pvc</u> , <u>51'</u> (material) (depth)			
(size) If telescope see back.			
(5) screen <u>10'</u> , <u>51'</u> (length) (depth to top)			
<u>12</u> , <u>pvc</u> (size) (material)			
(6) pump <u>3</u> , <u>30</u> (HP) (yield gpm)			
<u>Elc</u> (type power)			
(7) electric log (yes or no)			
(organization running log)			
(8) how well bottom plugged <u>Sand</u> <u>sharp</u>			
DRILLERS REMARKS:			


DEPT. OF NATURAL RESOURCES
 BUREAU OF LAND & WATER RESOURCES

JUN 14 1983

RECEIVED

If well telescopes please sketch and show depths.

GROUND LEVEL

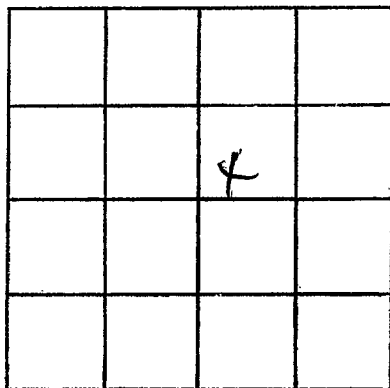

SECTION _____

Please indicate well location X.

ADDITIONAL INFORMATION

If more than one screen,
show locations of each on sketch.