

MISSISSIPPI DEPARTMENT OF NATURAL RESOURCES

Bureau of Land and Water Resources

Southport Mall

P.O. Box 10631

Jackson, Mississippi 39209

WATER WELL DRILLERS LOG

Pearl River
 02064
 5/12/83

May 12-83 19 Wallace Welding Pearl River
 date well completed firm name county well located

LANDOWNER: <u>MILE WISE</u>	description of formations encountered	from	to
<u>Part 1 Cameron</u>	<u>Red sandstone</u>	<u>0</u>	<u>12</u>
(mailing address)	<u>Coarse sand</u>	<u>12</u>	<u>38</u>
	<u>fragments</u>		
WELL LOCATION: <u>18</u>			
sec <u>24 T 4 N S</u> R. <u>10 E</u>			
	<u>Harleyville</u>		
_____ miles _____ of _____			
(distance) (direction) (nearest town)			
WELL PURPOSE: <u>Home</u>			
(home, irrigation, municipal, industrial)			
WELL COMPLETION DATA:			
(1) diameter (inches) <u>2"</u>			
(2) total depth (feet) <u>38'</u>			
(3) static water level (feet) <u>10</u> below top of ground.			
(4) casing <u>PVC</u> , <u>33'</u>			
(material) (depth)			
_____ if telescope see back.			
(size)			
(5) screen <u>5'</u> , <u>33"</u>			
(length) (depth to top)			
<u>15</u> , <u>PVC</u>			
(size) (material)			
(6) pump <u>NO</u>			
(HP) (yield gpm)			
_____ (type power)			
(7) electric log _____			
(yes or no)			
_____ (organization running log)			
(8) how well bottom plugged <u>Shank</u>			
DRILLERS REMARKS:			


DEPT. OF NATURAL RESOURCES
 BUREAU OF LAND & WATER RESOURCES

MAY 20 1983

RECEIVED

If well telescopes please sketch and show depths.

GROUND LEVEL

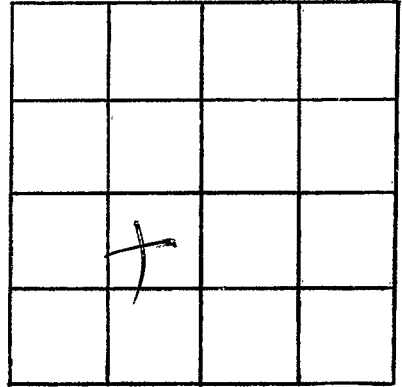

SECTION _____

Please indicate well location X.

ADDITIONAL INFORMATION

If more than one screen, show locations of each on sketch.