

MISSISSIPPI DEPARTMENT OF NATURAL RESOURCES

Bureau of Land and Water Resources

Southport Mall

P.O. Box 10631

Jackson, Mississippi 39209

WATER WELL DRILLERS LOG

Pearl R
 02007
 5/5/83

May 5-83 19 Walker Welding Pearl River
 date well completed firm name county well located

LANDOWNER: <u>J.P. Muhlisen</u>	description of formations encountered	from	to
<u>Caminis Miss</u> <u>Part 1</u> (mailing address)	<u>Red shale</u>	<u>0</u>	<u>65</u>
	<u>pink sand</u>	<u>65</u>	<u>80</u>
	<u>Blue shale</u>	<u>80</u>	<u>159</u>
	<u>hard core</u>	<u>15</u>	<u>205</u>
WELL LOCATION: sec <u>39</u> T <u>4</u> N R <u>10</u> E S W <u>15</u> miles <u>NW</u> <u>Princeton</u> (distance) (direction) (nearest town) <u>H. Colquhoun</u>			
WELL PURPOSE: <u>Home</u> (home, irrigation, municipal, industrial)			
WELL COMPLETION DATA:			
(1) diameter (inches) <u>2"</u>			
(2) total depth (feet) <u>205'</u>			
(3) static water level (feet) <u>126'</u> below above top of ground.			
(4) casing <u>PVC</u> <u>195'</u> (material) (depth)			
_____ if telescope see back. (size)			
(5) screen <u>10'</u> <u>195'</u> (length) (depth to top)			
<u>10</u> <u>PVC</u> (size) (material)			
(6) pump <u>1</u> <u>7</u> (HP) (yield gpm)			
<u>Elec</u> (type power)			
(7) electric log _____ (yes or no)			
_____ (organization running log)			
(8) how well bottom plugged <u>Sand</u> <u>shale</u>			
DRILLERS REMARKS: _____			


DEPT. OF NATURAL RESOURCES
 BUREAU OF LAND & WATER RESOURCES

MAY 20 1983

RECEIVED

If well telescopes please
sketch and show depths.

GROUND LEVEL

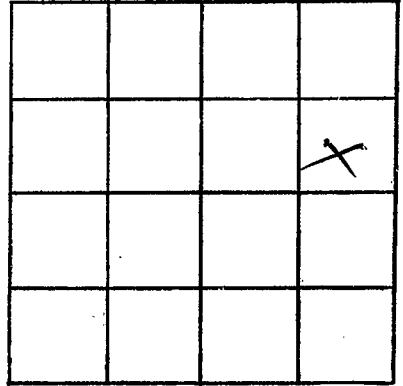

SECTION _____

Please indicate well location X.

ADDITIONAL INFORMATION

If more than one screen,
show locations of each on sketch.