

MISSISSIPPI DEPARTMENT OF NATURAL RESOURCES

Bureau of Land and Water Resources

Southport Mall

P.O. Box 10631

Jackson, Mississippi 39209

WATER WELL DRILLERS LOG

Pearl River
02028

3-28-83 19 Walkers Welding Pearl River
 date well completed firm name county well located

LANDOWNER: <u>Joe T. Fleen</u> <u>poplarville miss</u> (mailing address)	description of formations encountered	from	to
	<u>Red shell</u>	<u>0</u>	<u>10</u>
	<u>gyssul</u>	<u>12</u>	<u>22</u>
	<u>Sand</u>	<u>22</u>	<u>84</u>
WELL LOCATION:			
sec. <u>40</u> T. <u>4</u> N. R. <u>17</u> E. S W			
<u>16</u> miles <u>NW</u> <u>Perre</u> (distance) (direction) (nearest town)			
WELL PURPOSE: <u>Home</u> (home, irrigation, municipal, industrial)			
WELL COMPLETION DATA:			
(1) diameter (inches) <u>4"</u>			
(2) total depth (feet) <u>84'</u>			
(3) static water level (feet) <u>18</u> below above top of ground.			
(4) casing <u>PVC</u> <u>84'</u> (material) (depth)			
(size) if telescope see back.			
(5) screen <u>10'</u> <u>74'</u> (length) (depth to top)			
<u>12</u> <u>PVC</u> (size) (material)			
(6) pump <u>1/2</u> <u>12</u> (HP) (yield gpm)			
<u>Elect</u> (type power)			
(7) electric log (yes or no)			
(organization running log)			
(8) how well bottom plugged <u>Sand</u> <u>Shrap</u>			
DRILLERS REMARKS:			


DEPT. OF NATURAL RESOURCES
 BUREAU OF LAND & WATER RESOURCES

APR - 4 1983

RECEIVED

If well telescopes please sketch and show depths.

GROUND LEVEL

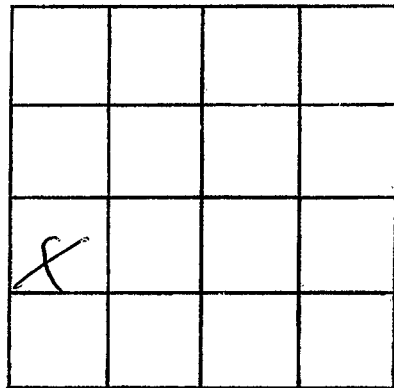

SECTION _____

Please indicate well location X.

ADDITIONAL INFORMATION

If more than one screen,
show locations of each on sketch.