

MISSISSIPPI DEPARTMENT OF NATURAL RESOURCES

Bureau of Land and Water Resources

Southport Mall

P.O. Box 10631

Jackson, Mississippi 39209

WATER WELL DRILLERS LOG

POUNCEY WATER WELL DRILLING

Pearl River
 2069
 3/11/83

3-11-83 date well completed POUNCEY WATER WELL DRILLING firm name Pearl River county well located

LANDOWNER:	Description of formations encountered	from	to
Mrs. Ruby Ferguson Hendefield - (mailing address)	Top to Clay -	0	18
	Silty sand	18	46
	good casing	46	62
	shallow well		
WELL LOCATION: sec. 23 T. 4 N. R. 18 E. S. 5 1 1/2 miles (distance) S (direction) of Hendefield (nearest town) (C. Laurel)			
WELL PURPOSE: Home (home, irrigation, municipal, industrial)			
WELL COMPLETION DATA:			
(1) diameter (inches) 2			
(2) total depth (feet) 62			
(3) static water level (feet) 40 below top of ground			
(4) casing PVC 52 (material) (depth)			
2 (size) if telescope see back.			
(5) screen 10 (length) 52 (depth to top)			
PVC (size) PVC (material)			
(6) pump 6 (HP) (yield gpm)			
PC (type power)			
(7) electric log (yes or no)			
(organization running log)			
(8) how well bottom plugged Sealed			

DRILLERS REMARKS:


DEPT. OF NATURAL RESOURCES
 BUREAU OF LAND & WATER RESOURCES

MAY 18 1983

RECEIVED

If well telescopes please sketch and show depths.

GROUND LEVEL

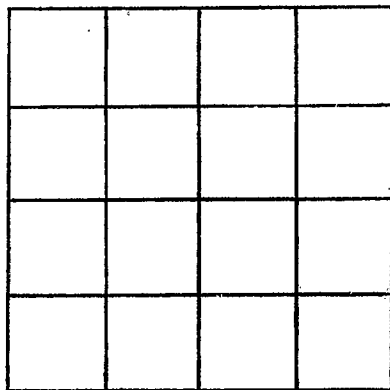

SECTION _____

Please indicate well location X.

ADDITIONAL INFORMATION

If more than one screen,
show locations of each on sketch.