

MISSISSIPPI DEPARTMENT OF NATURAL RESOURCES

Bureau of Land and Water Resources

Southport Mall

P.O. Box 10631

Jackson, Mississippi 39209

WATER WELL DRILLERS LOG

PEARL RIVER  
Q 2072

July 6, 84 19 date well completed  
Walkers Welding firm name  
Pearl River county well located

LANDOWNER: <u>Reggie Wise</u> <u>R. L. Cummings, Jr.</u> <u>Henleyfield</u> (mailing address)	description of formations encountered	from	to
	<u>Red shale</u>	<u>0</u>	<u>18</u>
	<u>Red sand</u>	<u>18</u>	<u>28</u>
	<u>Blue shale</u>	<u>28</u>	<u>110</u>
	<u>sand fin rocks</u>	<u>110</u>	<u>146</u>
WELL LOCATION:			
sec. <u>24</u> T. <u>4</u> N. R. <u>18</u> E. S. W.			
<u>15</u> miles <u>NE</u> of <u>Picayune</u> (distance) (direction) (nearest town)			
WELL PURPOSE: <u>Home</u> (home, irrigation, municipal, industrial)			
WELL COMPLETION DATA:			
(1) diameter (inches) <u>4"</u>			
(2) total depth (feet) <u>146'</u>			
(3) static water level (feet) <u>65</u> below above top of ground.			
(4) casing <u>PVC</u> , <u>136'</u> (material) (depth)			
(size) If telescope see back.			
(5) screen <u>10'</u> , <u>136'</u> (length) (depth to top)			
<u>10</u> , <u>PVC</u> (size) (material)			
(6) pump <u>1/2</u> , <u>8</u> (HP) (yield gpm)			
<u>Elec</u> (type power)			
(7) electric log _____ (yes or no)			
_____ (organization running log)			
(8) how well bottom plugged <u>Sand</u> <u>sharp</u>			
DRILLERS REMARKS:			


DEPT. OF NATURAL RESOURCES  
BUREAU OF LAND & WATER RESOURCES

JUL 24 1984

RECEIVED

If well telescopes please sketch and show depths.

GROUND LEVEL

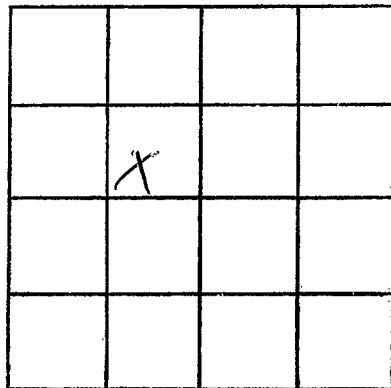

SECTION \_\_\_\_\_

Please indicate well location X.

ADDITIONAL INFORMATION

If more than one screen,  
show locations of each on sketch.