

MISSISSIPPI DEPARTMENT OF NATURAL RESOURCES

Bureau of Land and Water Resources

Southport Mall

P.O. Box 10631

Jackson, Mississippi 39209

WATER WELL DRILLERS LOG

PEARL RIVER

Q 2073

July 16-84, 19 Walker Welding Pearl River  
 date well completed firm name county well located

LANDOWNER: Adair Mitchell

R1 Carniers Miss

H. Enley field  
 (mailing address)

WELL LOCATION:

sec 12 T 4 N R 18 E  
 S W  
15 miles NE of Pearl  
 (distance) (direction) (nearest town)

WELL PURPOSE: Home  
 (home, irrigation, municipal, industrial)

WELL COMPLETION DATA:

- (1) diameter (inches) 2"
- (2) total depth (feet) 60'
- (3) static water level (feet) 32 below above top of ground.
- (4) casing PVC, 50'  
 (material) (depth)

         if telescope see back.  
 (size)

- (5) screen 10', 50'  
 (length) (depth to top)  
12, PVC  
 (size) (material)

- (6) pump 1 Elek  
 (HP) (yield gpm)  
 (type power)

- (7) electric log 10  
 (yes or no)

          
 (organization running log)

- (8) how well bottom plugged Sand  
slush

DRILLERS REMARKS:

description of formations encountered

from

to

Red shell 0 16  
pebbles 16 60  
little gravel


DEPT. OF NATURAL RESOURCES  
 BUREAU OF LAND & WATER RESOURCES

JUL 24 1984

RECEIVED

If well telescopes please sketch and show depths.

GROUND LEVEL

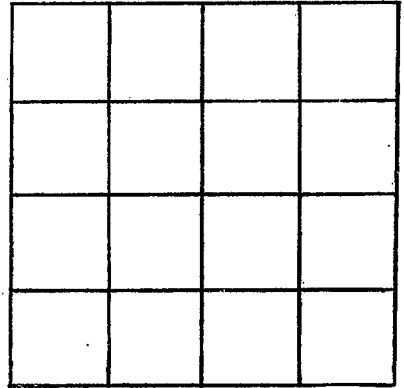

SECTION \_\_\_\_\_

Please indicate well location X.

ADDITIONAL INFORMATION

If more than one screen,  
show locations of each on sketch.