

MISSISSIPPI DEPARTMENT OF NATURAL RESOURCES

Bureau of Land and Water Resources

Southport Mall

P.O. Box 10631

Jackson, Mississippi 39209

WATER WELL DRILLERS LOG

Pearl River
02075

Jan 7-84
date well completed

Walbers Welding Pearl River
firm name county well located

LANDOWNER: Lee Star
R1 Canine Miss
Hendryfield
(mailing address)

WELL LOCATION:
sec 34 T 4 N R 18 E
S W
15 miles NW Pecan
(distance) (direction) (nearest town)

WELL PURPOSE: Home
(home, irrigation, municipal, industrial)

WELL COMPLETION DATA: 2-5-84

- (1) diameter (inches) 2'
- (2) total depth (feet) 252'
- (3) static water level (feet) 29 below above top of ground.
- (4) casing PVC 237'
(material) (depth)
(size) If telescope see back.
- (5) screen 15' 237'
(length) (depth to top)
12 PVC
(size) (material)
- (6) pump 1 10
(HP) (yield gpm)
Elec
(type power)
- (7) electric log (yes or no)
(organization running log)
- (8) how well bottom plugged Good
check

description of formations encountered	from to	
Red shale	0	15
gravel	15	60
Brown shale	60	65
Blue shale	65	210
Blue sandstone beds	210	252

DRILLERS REMARKS:


DEPT. OF NATURAL RESOURCES
BUREAU OF LAND & WATER RESOURCES

FEB 6 1984

RECEIVED

If well telescopes please sketch and show depths.

GROUND LEVEL

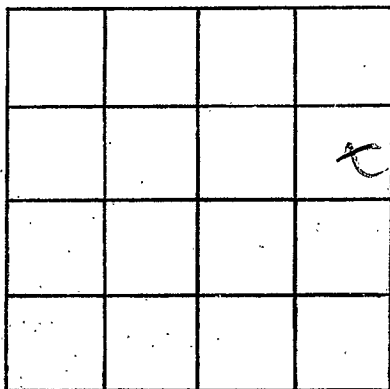

SECTION _____

Please indicate well location X.

ADDITIONAL INFORMATION

If more than one screen,
show locations of each on sketch.