

MISSISSIPPI DEPARTMENT OF NATURAL RESOURCES

Bureau of Land and Water Resources

Southport Mall

P.O. Box 10631

Jackson, Mississippi 39209

WATER WELL DRILLERS LOG

Pearl River
0207

Jan 11 1984 date well completed Walker Welding Pearl River firm name county well located

LANDOWNER: Steve Manning
Box 1 Cannonville Miss
Henryfield
(mailing address)

description of formations encountered	from to	
<u>Red shale</u>	<u>0</u>	<u>16</u>
<u>clay gravel</u>	<u>16</u>	<u>36</u>
<u>white chalk</u>	<u>36</u>	<u>40</u>
<u>fine gravel</u>	<u>40</u>	<u>78</u>
<u>concrete roof</u>		

WELL LOCATION:
sec 36 T 4 N R 18 S W
15 miles NW of Pigeon
(distance) (direction) (nearest town)

WELL PURPOSE: Home
(home, irrigation, municipal, industrial)

WELL COMPLETION DATA:

- (1) diameter (inches) 2"
- (2) total depth (feet) 78'
- (3) static water level (feet) 40' below top of ground.
- (4) casing pvc 68'
(material) (depth)
(size) if telescope see back.
- (5) screen 10 68'
(length) (depth to top)
10 pvc
(size) (material)
- (6) pump 1 0
(HP) (yield gpm)
Elec
(type power)
- (7) electric log (yes or no) _____
(organization running log) _____
- (8) how well bottom plugged Sand
clay

DRILLERS REMARKS:


DEPT. OF NATURAL RESOURCES
BUREAU OF LAND & WATER RESOURCES

FEB - 6 1984

RECEIVED

If well telescopes please sketch and show depths.

GROUND LEVEL

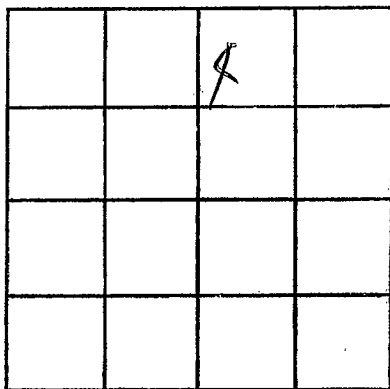

SECTION _____

Please indicate well location X.

ADDITIONAL INFORMATION

If more than one screen, show locations of each on sketch.