

MISSISSIPPI DEPARTMENT OF NATURAL RESOURCES

Bureau of Land and Water Resources

Southport Mall

P.O. Box 10631

Jackson, Mississippi 39209

WATER WELL DRILLERS LOG

Paul River
00
2077

Jan 29 - 84 date well completed Walker Welding firm name Paul River county well located

LANDOWNER	description of formations encountered	from	to
<u>Robert J. Meder</u>			
<u>R1 Box 313A</u>	<u>Red shale</u>	<u>0</u>	<u>20</u>
<u>Cameron, Miss</u> (mailing address)	<u>Sand</u>	<u>20</u>	<u>62</u>

WELL LOCATION:
 sec 36 T 4 S R 18 W
15 miles NW of Piney
 (distance) (direction) (nearest town)

WELL PURPOSE: Home
 (home, irrigation, municipal, industrial)

WELL COMPLETION DATA: 1-29-84

- (1) diameter (inches) 4"
- (2) total depth (feet) 62'
- (3) static water level (feet) 33 below above top of ground.
- (4) casing PVC, 52'
 (material) (depth)
 (size) If telescope see back.
- (5) screen 10', 52'
 (length) (depth to top)
10, PVC
 (size) (material)
- (6) pump 1/2, 8
 (HP) (yield gpm)
Elec
 (type power)
- (7) electric log (yes or no) _____

(organization running log) _____

(8) how well bottom plugged Sand
Shamp

DRILLERS REMARKS: _____


DEPT. OF NATURAL RESOURCES
 BUREAU OF LAND & WATER RESOURCES

FEB - 6 1984

RECEIVED

If well telescopes please sketch and show depths.

GROUND LEVEL

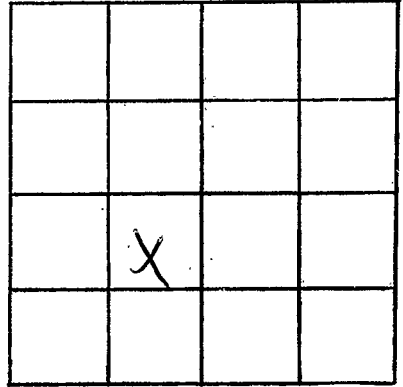

SECTION _____

Please indicate well location X.

ADDITIONAL INFORMATION

If more than one screen,
show locations of each on sketch.