

MISSISSIPPI DEPARTMENT OF NATURAL RESOURCES

Bureau of Land and Water Resources

Southport Mall

P.O. Box 10631

Jackson, Mississippi 39209

WATER WELL DRILLERS LOG

Paul River
0 2078

3-23-84 19 Walker Welding firm name Paul River county well located
date well completed


LANDOWNER: <u>Clayton Covel</u>	description of formations encountered	from	to
<u>Picayune Miss</u> (mailing address)	<u>Clay gravel</u> <u>Blk. shale</u> <u>Blue shaly rocks</u> <u>Sand</u>	<u>0</u> <u>54</u> <u>126</u> <u>152</u>	<u>54</u> <u>126</u> <u>152</u> <u>192</u>
WELL LOCATION: <u>sec 39 T 4 N R 18 E</u> <u>15</u> miles <u>NW</u> of <u>Picayune</u> (distance) (direction) (nearest town)			
WELL PURPOSE: <u>Home</u> (home, irrigation, municipal, industrial)			
WELL COMPLETION DATA:			
(1) diameter (inches) <u>4"</u>			
(2) total depth (feet) <u>192</u>			
(3) static water level (feet) <u>48</u> below top of ground.			
(4) casing <u>PVC</u> <u>172'</u> (material) (depth)			
(size) If telescope see back.			
(5) screen <u>20</u> <u>172'</u> (length) (depth to top)			
(6) pump <u>10</u> <u>PVC</u> (size) (material)			
(7) pump <u>1/2</u> <u>18</u> (HP) (yield gpm)			
<u>Elec</u> (type power)			
(7) electric log (yes or no)			
(organization running log)			
(8) how well bottom plugged <u>sand</u> <u>shale</u>			
DRILLERS REMARKS:			

DEPT. OF NATURAL RESOURCES
BUREAU OF LAND & WATER RESOURCES

APR 11 1984
RECEIVED

If well telescopes please sketch and show depths.

GROUND LEVEL

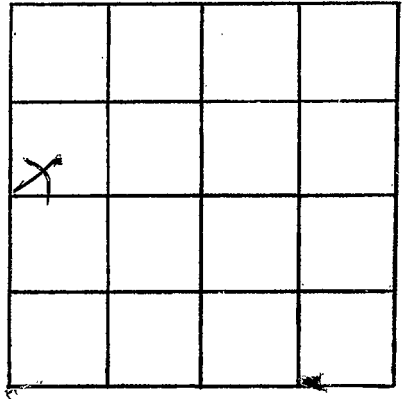

SECTION _____

Please indicate well location X.

ADDITIONAL INFORMATION

If more than one screen,
show locations of each on sketch.