

MISSISSIPPI DEPARTMENT OF NATURAL RESOURCES

Bureau of Land and Water Resources

Southport Mall

P.O. Box 10631

Jackson, Mississippi 39209

WATER WELL DRILLERS LOG

Pearl River
0 209

3-24-84 date well completed Walker Welding firm name Pearl River county well located

LANDOWNER:	description of formations encountered	from	to
<u>Jack Burks</u>	<u>Red shale</u>	<u>0</u>	<u>51</u>
<u>R1 Carnine Miss</u>	<u>Sand shale</u>	<u>51</u>	<u>87</u>
<u>Herbyfield</u> (mailing address)			

WELL LOCATION:
 sec 26 T 4 N R 18 E
 S W
15 miles NW Picayune
 (distance) (direction) (nearest town)

WELL PURPOSE: Home
 (home, irrigation, municipal, industrial)


- WELL COMPLETION DATA:
- (1) diameter (inches) 4"
 - (2) total depth (feet) 87
 - (3) static water level (feet) 36 below above top of ground.
 - (4) casing PVC 77'
 (material) (depth)
 (size) if telescope see back.
 - (5) screen 10' 77'
 (length) (depth to top)
10 PVC
 (size) (material)
 - (6) pump 1/2 (HP) 12 (yield gpm)
Eloc
 (type power)
 - (7) electric log (yes or no) _____
 (organization running log) _____
 - (8) how well bottom plugged sand
shack

DRILLERS REMARKS: _____

MISSISSIPPI DEPARTMENT OF NATURAL RESOURCES
 BUREAU OF LAND AND WATER RESOURCES
 APR 11 1984
RECEIVED

If well telescopes please sketch and show depths.

GROUND LEVEL

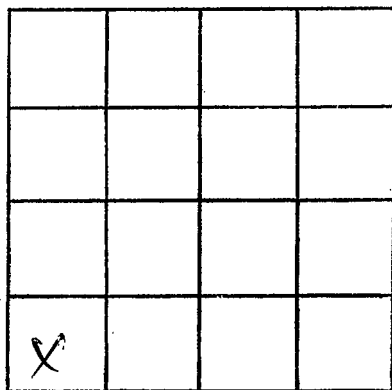

SECTION _____

Please indicate well location X.

ADDITIONAL INFORMATION

If more than one screen,
show locations of each on sketch.