

MISSISSIPPI DEPARTMENT OF NATURAL RESOURCES

Bureau of Land and Water Resources

Southport Mall

P.O. Box 10631

Jackson, Mississippi 39209

WATER WELL DRILLERS LOG

Pearl River
D2080

June 5-84 19 Walton Wellbry Pearl River
 date well completed firm name county well located

LANDOWNER: Dough H. ...
B1 Cannon Miss
 (mailing address)

description of formations encountered	from	to
<u>Red shale</u>	<u>0</u>	<u>10</u>
<u>Sand gravel</u>	<u>10</u>	<u>54</u>

WELL LOCATION:
 sec 36 T 4 N R 18 W
15 miles NW of Pearl River
 (distance) (direction) (nearest town)

WELL PURPOSE: Home
 (home, irrigation, municipal, industrial)

- WELL COMPLETION DATA:
- (1) diameter (inches) 2"
 - (2) total depth (feet) 54
 - (3) static water level (feet) 26 below top of ground.
 - (4) casing PVC 44'
 (material) (depth)
 - (size) if telescope see back.
 - (5) screen 10' 44'
 (length) (depth to top)
 - (size) PVC
 (material)
 - (6) pump 1 12
 (HP) (yield gpm)
 - Electric
 (type power)
 - (7) electric log (yes or no) _____
 (organization running log) _____
 - (8) how well bottom plugged S.S.

DRILLERS REMARKS: _____


DEPT. OF NATURAL RESOURCES
 BUREAU OF LAND & WATER RESOURCES

JUN 18 1984

RECEIVED

If well telescopes please
sketch and show depths.

GROUND LEVEL

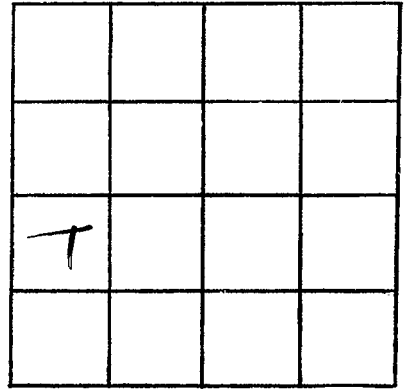

SECTION _____

Please indicate well location X.

ADDITIONAL INFORMATION

If more than one screen,
show locations of each on sketch.