

MISSISSIPPI DEPARTMENT OF NATURAL RESOURCES

Bureau of Land and Water Resources

Southport Mall

P.O. Box 10631

Jackson, Mississippi 39209

WATER WELL DRILLERS LOG

Pearl River
00082

Sept 13 1984 Walker Welding Pearl River
 date well completed firm name county well located


LANDOWNER: <u>J. Johnson</u>	description of formations encountered	from	to
<u>RFD 1</u>		<u>Gravelly</u>	<u>0</u>
<u>Cannine Miss</u> (mailing address)	<u>fine sand</u>	<u>13</u>	<u>154</u>
WELL LOCATION: sec. <u>3</u> T. <u>4</u> N. R. <u>18</u> W. S. W.	<u>blue shell</u>	<u>154</u>	<u>234</u>
<u>Beyond Chapel 18 NW</u> (distance) miles (direction) (nearest town)	<u>Coarse sand & gravel</u>	<u>234</u>	<u>250</u>
WELL PURPOSE: <u>Home</u> (home, irrigation, municipal, industrial)			
WELL COMPLETION DATA: (1) diameter (inches) <u>4"</u>			
(2) total depth (feet) <u>270'</u>			
(3) static water level (feet) <u>162'</u> below top of ground.			
(4) casing <u>pvc</u> <u>260'</u> (material) (depth)			
(5) screen <u>10'</u> <u>260'</u> (length) (depth to top)			
(6) pump <u>1</u> <u>8</u> (HP) (yield gpm)			
(7) electric log _____ (yes or no)			
(8) how well bottom plugged <u>S.S.</u>			
DRILLERS REMARKS:			

MISSISSIPPI DEPARTMENT OF NATURAL RESOURCES
 BUREAU OF LAND & WATER RESOURCES

OCT - 9 1984
RECEIVED

If well telescopes please sketch and show depths.

GROUND LEVEL

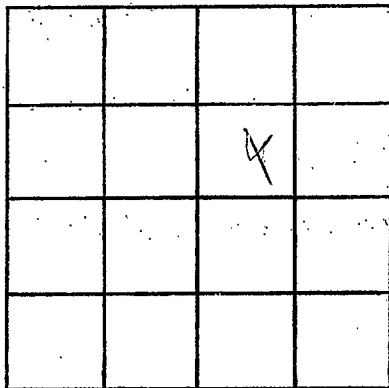

SECTION _____

Please indicate well location X.

ADDITIONAL INFORMATION

If more than one screen,
show locations of each on sketch.