

**MISSISSIPPI DEPARTMENT OF NATURAL RESOURCES**  
**Bureau of Land and Water Resources**  
 Southport Mall  
 P.O. Box 10631  
 Jackson, Mississippi 39209  
**WATER WELL DRILLERS LOG**

Pearl River  
02083

Nov 15 1984 Walker Welding Pearl River  
 date well completed firm name county well located

LANDOWNER: Jeff Sproul  
R1 Cousins Miss  
 (mailing address)

description of formations encountered	from	to
<u>Sand</u>	<u>0</u>	<u>10</u>
<u>Clay</u>	<u>10</u>	<u>12</u>
<u>Sand</u>	<u>12</u>	<u>47</u>

WELL LOCATION:  
 sec 22 T 4 N S R 18 W  
 (distance) miles (direction) of (nearest town)

WELL PURPOSE: Home  
 (home, irrigation, municipal, industrial)

- WELL COMPLETION DATA:
- (1) diameter (inches) 4"
  - (2) total depth (feet) 47'
  - (3) static water level (feet) 30 below top of ground.
  - (4) casing PVC, 37,  
 (material) (depth)  
 (size) If telescope see back.
  - (5) screen 10, 37  
 (length) (depth to top)  
10, PVC  
 (size) (material)
  - (6) pump 1/2, 5  
 (HP) (yield gpm)  
E  
 (type power)
  - (7) electric log             
 (yes or no)

            
 (organization running log)

(8) how well bottom plugged shut  
thru

DRILLERS REMARKS:           


DEPT. OF NATURAL RESOURCES  
 BUREAU OF LAND & WATER RESOURCES

DEC 18 1984

**RECEIVED**

If well telescopes please sketch and show depths.

GROUND LEVEL

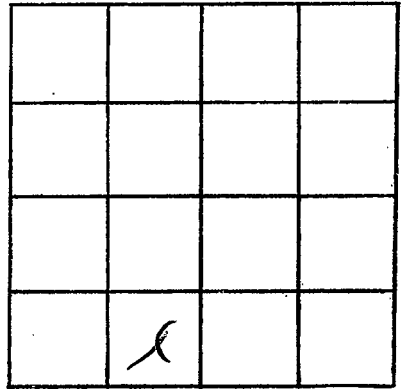

SECTION \_\_\_\_\_

Please indicate well location X.

ADDITIONAL INFORMATION

If more than one screen,  
show locations of each on sketch.