

MISSISSIPPI DEPARTMENT OF NATURAL RESOURCES

Bureau of Land and Water Resources

Southport Mall

P.O. Box 10631

Jackson, Mississippi 39209

WATER WELL DRILLERS LOG

PEARL RIVER
 Q2085

5-13 19 85 WALKERS WELDING P.R.
 date well completed firm name county well located

LANDOWNER: MICKEY TORAZ
RT, 1
CARRIERE, MS.
 (mailing address)

description of formations encountered	from	to
	CLAY	0
SAND	89	93
CLAY	93	156

WELL LOCATION:
 sec. 17 T 4 S R 18 W
10 miles N.W. of CARRIERE
 (distance) (direction) (nearest town)

SAND	156	167
CLAY	167	169
SAND	169	182

WELL PURPOSE: HOME
 (home, irrigation, municipal, industrial)

WELL COMPLETION DATA:

(1) diameter (inches) 2

(2) total depth (feet) 182

(3) static water level (feet) 67 below ~~above~~ top of ground.

(4) casing PVC, 182,
 (material) (depth)
 (size) if telescope see back.


(5) screen 2, 172,
 (length) (depth to top)
2, PVC
 (size) (material)

(6) pump 1, 8
 (HP) (yield gpm)
ELEC.
 (type power)

(7) electric log _____
 (yes or no)

 (organization running log)

(8) how well bottom plugged SANDSHARK

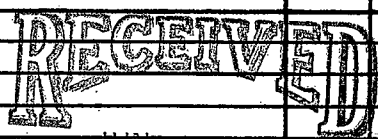

JUN 25 1985

DRILLERS REMARKS:

Department of Natural Resources
 Bureau of Land & Water Resources

If well telescopes please
sketch and show depths.

GROUND LEVEL

1			

SECTION _____

Please indicate well location X.

ADDITIONAL INFORMATION

If more than one screen,
show locations of each on sketch.